Company: US ROCKIES REGION			**Site:** UPRR 42 PAN AM 1			
Project: COLORADO-WELD			**Common Well Name:** UPRR 42 PAN AM 1			
API No: 0512307231	Datum: RKB		Section: 29		Div of Quarter Section: NW	
Latitude: 40.193853°	Elevation: 4,907.0usft		Township: 3	N	Div of Section: SW	
Longitude: -104.808227°	Water Depth: 4,898.0usft		Range: 66	W		

Casing Information	Casing Size & Weight	Cement Fluid (sacks)	Cement Depths (ft)	Schematic (1/5/2013)	Hole Size (in)	MD / PBMD (usft)	Perforation Intervals (usft)
SURFACE CASING - Set @ 567.0usft	8.625in, 24.00ppf	, , 500	9 (TOC) 568	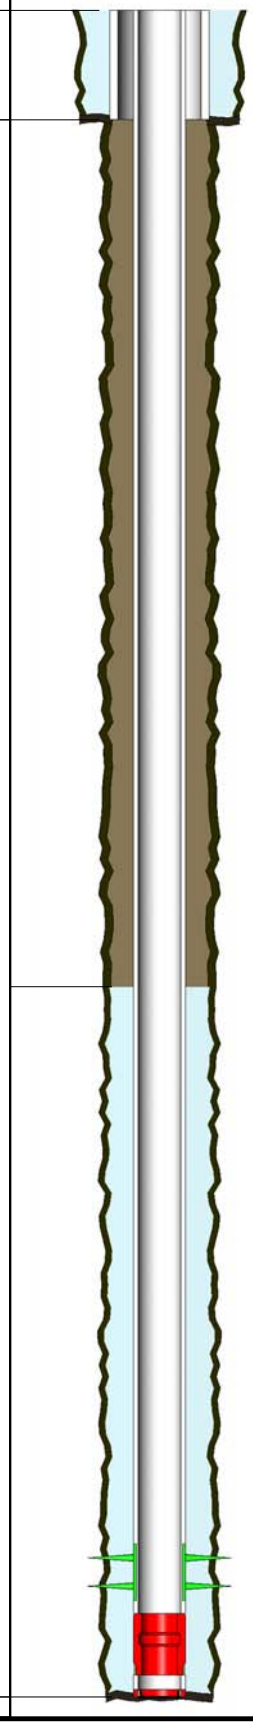			
PRODUCTION CASING - Set @ 7,972.0usft	4.500in, 11.50ppf 4.500in, 11.50ppf	, 2% GEL 10% SALT 0.75% TIC, 200	5000 (TOC) 7970			MD: 7,972 PBMD: 7,932	7,855 - 7,855 - J SAND 7,846 - 7,872 - J SAND