Modified Regulatory Wellbore Schematic

HEDIGER 14-9-67 1H

Chesapeake ENERGY

Field: Niobrara
County: WELD
State: COLORADO
Elevation: GL 5,364.0 KB 5,384.0 KB Height: 20.0
Location: SEC 14-9N-67W, 350 FSL & 1980 FEL

Spud Date: 7/24/2011
Rig Release Date: 8/9/2011
Initial Compl. Date:
API #: 0512333525
CHK Property #: 636418
1st Sales Date:
PBTD:
TD: 11,667.6

HORIZONTAL - Original Hole, 1/10/2013 8:23:52 AM

Vertical schematic (actual)

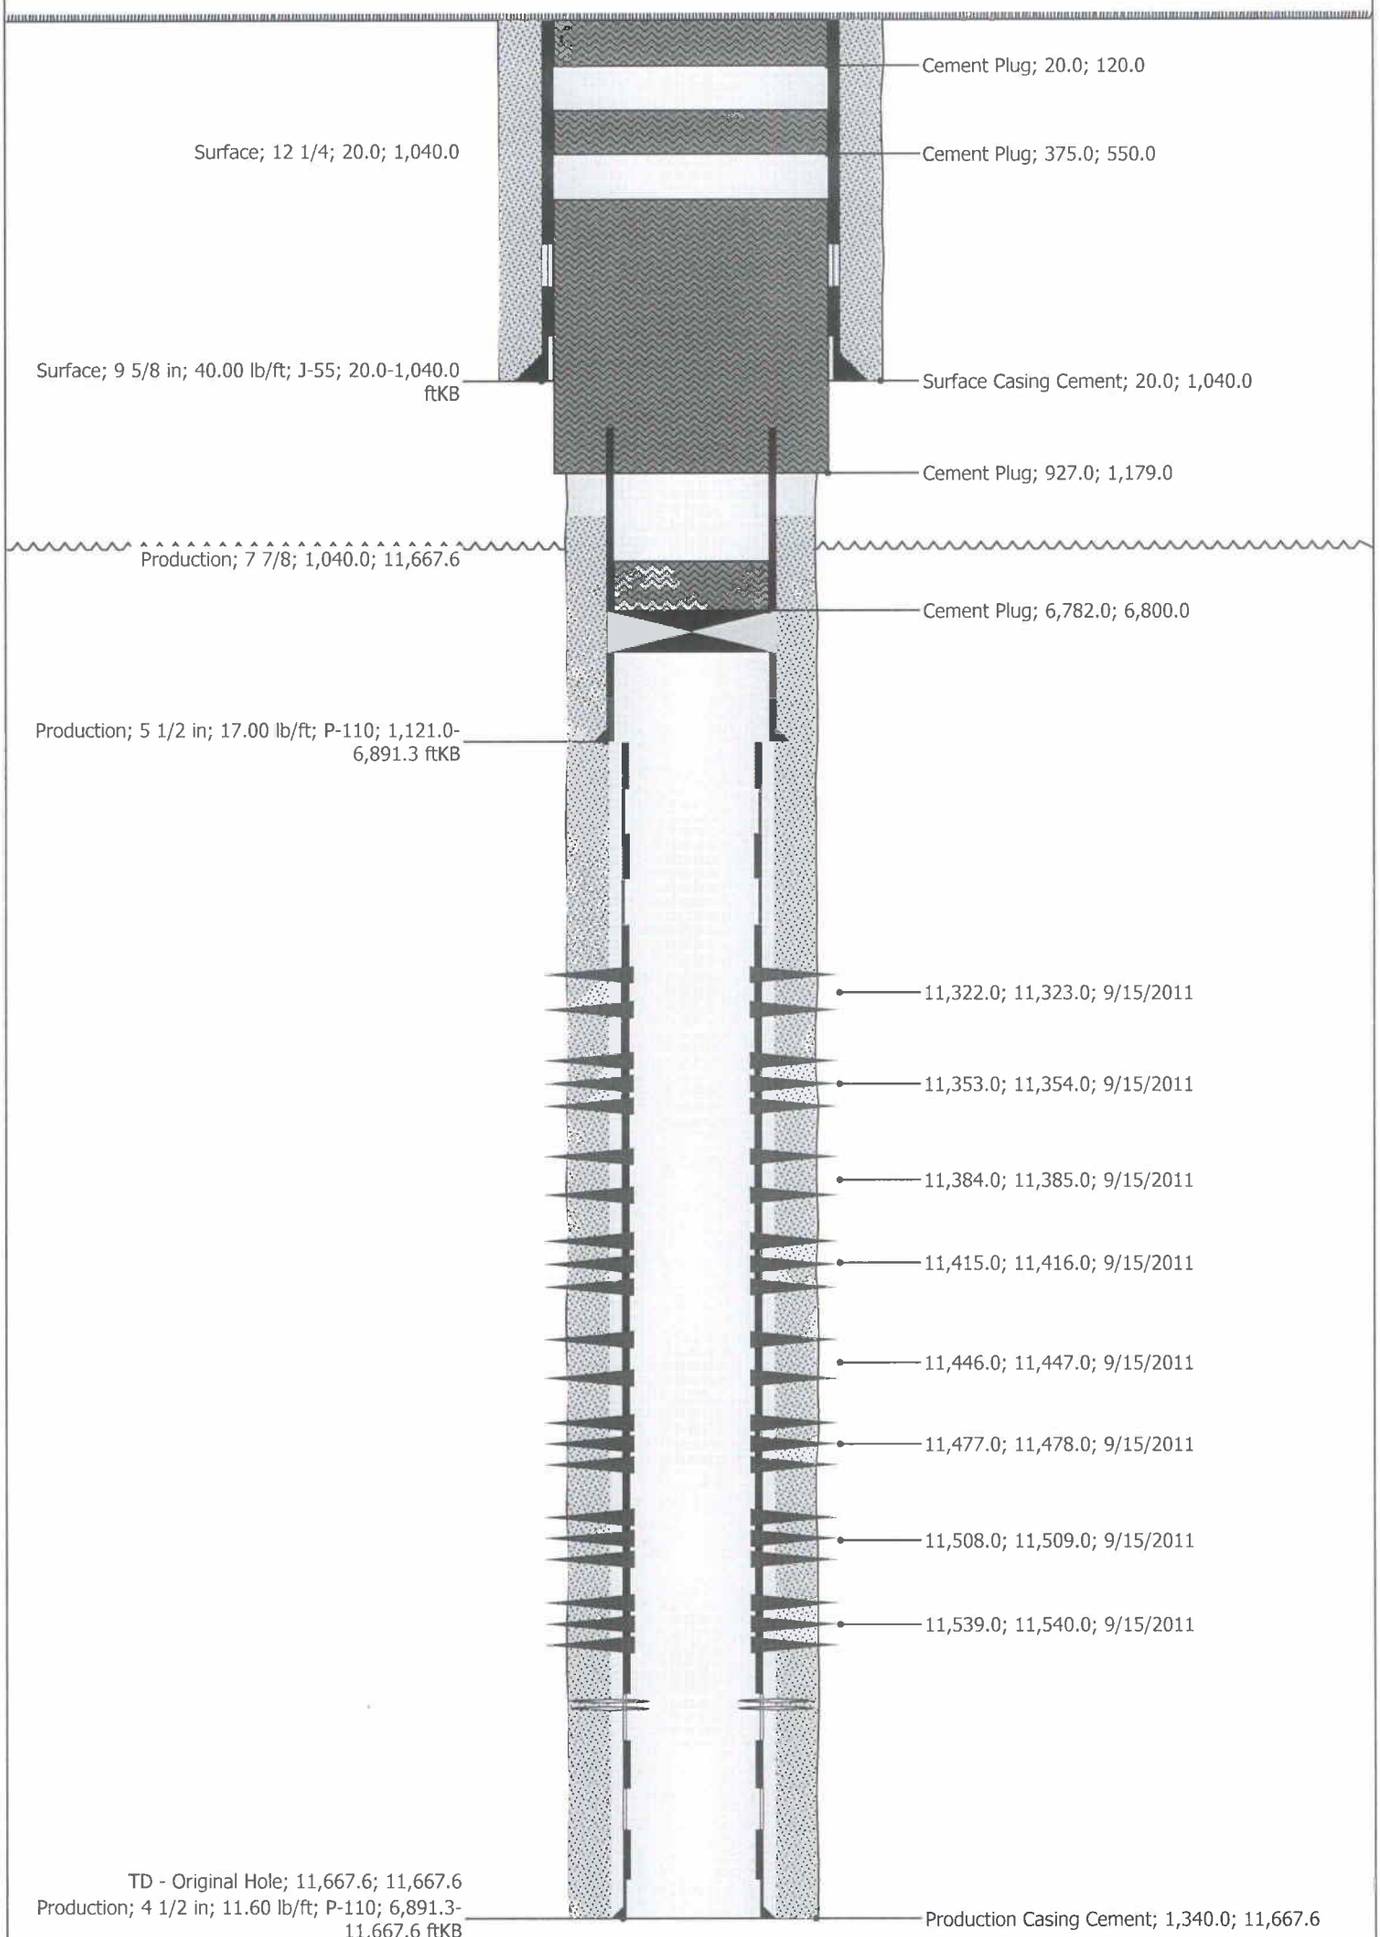

Report Printed: 1/10/201