

Well

Operator

Location

County

State

Field

Footages

Aristocrat Angus 4-4

EnCana Oil & Gas (USA) Inc.

SESW Section 4-T3N-R65W

WELD

Colorado

Wattenberg

768' FSL; 1928' FWL

Spud Date:

07-20-12

TD Date:

07-24-12

Log Tops

Sussex


4735'

Niobrara

7298'

Codell

7578'

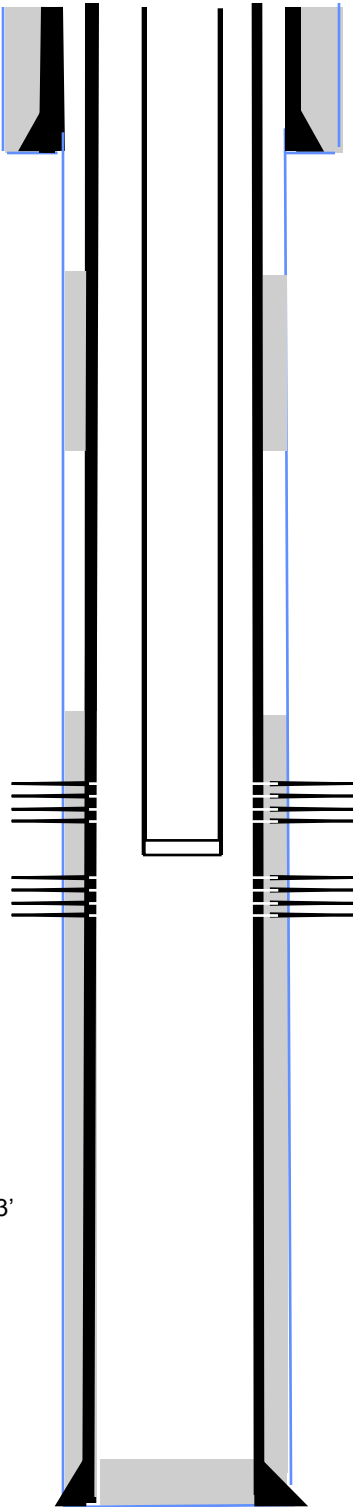

Surface Casing and Cement
8 5/8" ,landed @ 713',cemented with 295 sxs

Main Hole
7-7/8" to TD

Production Casing and Cement
4-1/2" , landed @ 7816',cemented with 635 sxs

CBP
Set @ 7270'. 08-31-12
Drilled out on 09-05-12

Perf'd the Niobrara from 7308-7309.5, 7367-7369.5, 7463-7466' @ 4 spf
Frac'd the Niobrara 7308-7309.5, 7367-7369.5,7463-7466' (28 holes), w/ 100,800 gals 18 # Vistar Hybrid cross linked gel containing 250,760 # 30/50 sand. 08-14-12

CFP
Set @ 7200'. 08-14-12
Drilled out on 09-05-12

Perf'd the Codell from 7,580' – 7,594' @ 3 spf
Frac'd the Codell 7,580' – 7,594' (42 holes) w/ 90,678 gal 22# Vistar Hybrid cross linked gel containing 250,040 # 30/50 sand. 08-13-12

Production Tubing
2-3/8" tubing, set @ 7553.23'

7816' — Driller's TD