

Well

Operator

Location

County

State

Field

Footages

DEASON 22-36

EnCana Oil & Gas (USA) Inc.

NENW Section 36-T2N-R69W

BOULDER

Colorado

WATTENBERG

1033' FNL; 1928' FWL

Spud Date: 08-13-12

TD Date: 08-17-12

Log Tops


Sussex	4338'
Niobrara	7420'
Codell	7716'
J Sand	8148'

Production Tubing  
2-3/8" tubing, set @ 8133'

8290'

—

Driller's TD

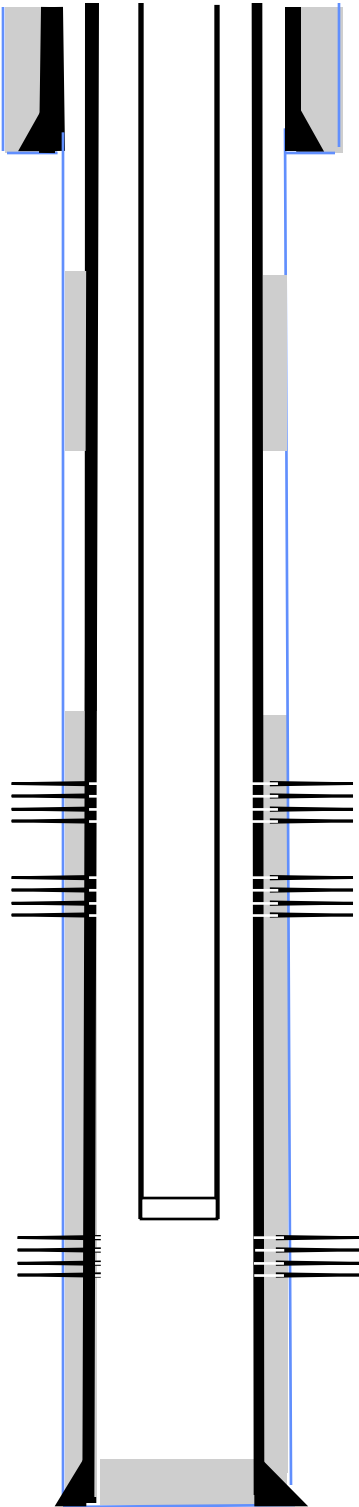

**Surface Casing and Cement**  
8 5/8" landed @ 880', cemented with 375 sxs

**Main Hole**  
7-7/8" to TD

**Production Casing and Cement**  
4-1/2", 11.6#, landed @ 8276', cemented with 720 sxs

**CBP**  
Set @ 7470'. 09-19-12  
Drilled out on 09-20-12

Perf'd the Niobrara from 7503'-7515' @ 4 spf  
Frac'd the Niobrara 7503-7515', (48 holes), w/ 102,900 gals 18 # Vistar Hybrid cross linked gel containing 250,640 # 30/50 sand. 09-17-12

**CFP**  
Set @ 7565'. 09-15-12  
Drilled out on 09-20-12

Perf'd the Codell from 7718'-7732' @ 3 spf  
Frac'd the Codell 7718'-7732' (42 holes) w/ 88,620 gal 22# Vistar Hybrid cross linked gel containing 253,220 # 30/50 sand. 09-15-12

**CFP**  
Set @ 7778'. 09-14-12  
Drilled out on 09-20-12

Perf'd the J Sand from 8150'-8155', 8160'-8179' @ 2 spf  
Frac'd the J-Sand 8150'-8155', 8160'-8179', (48 holes)w/ 64,680 gal 18 # VistarHybrid cross linked gel containing 250,420 # 20/40 Sand. 09-14-12