BUSYGULLY 13-54-12-3

WELL SCHEMATIC

1/22/2013

Surface Loc: NENW Sec 12, T13S, R54W **Lat./Long.:** 38.933676° & -103.399755° (Nad 83)

BH Loc: NENW Sec 12, T13S, R54W **TD:** 473' MD

County: LINCOLN **State:** COLORADO **TVD:** 473' TVD **API#** 05-073-06490

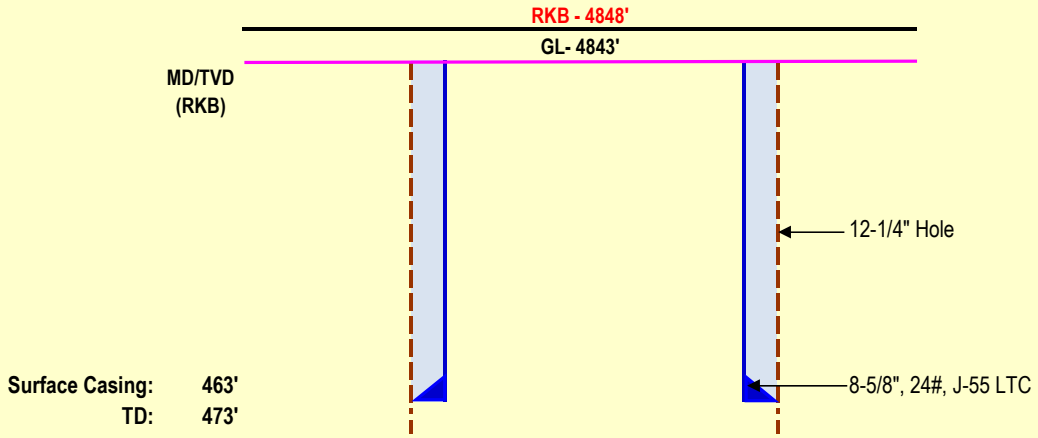

NOT TO SCALE