


Well Name: ADLER 44-10

VERTICAL - ORIGINAL HOLE, 1/21/2013 2:41:54 PM

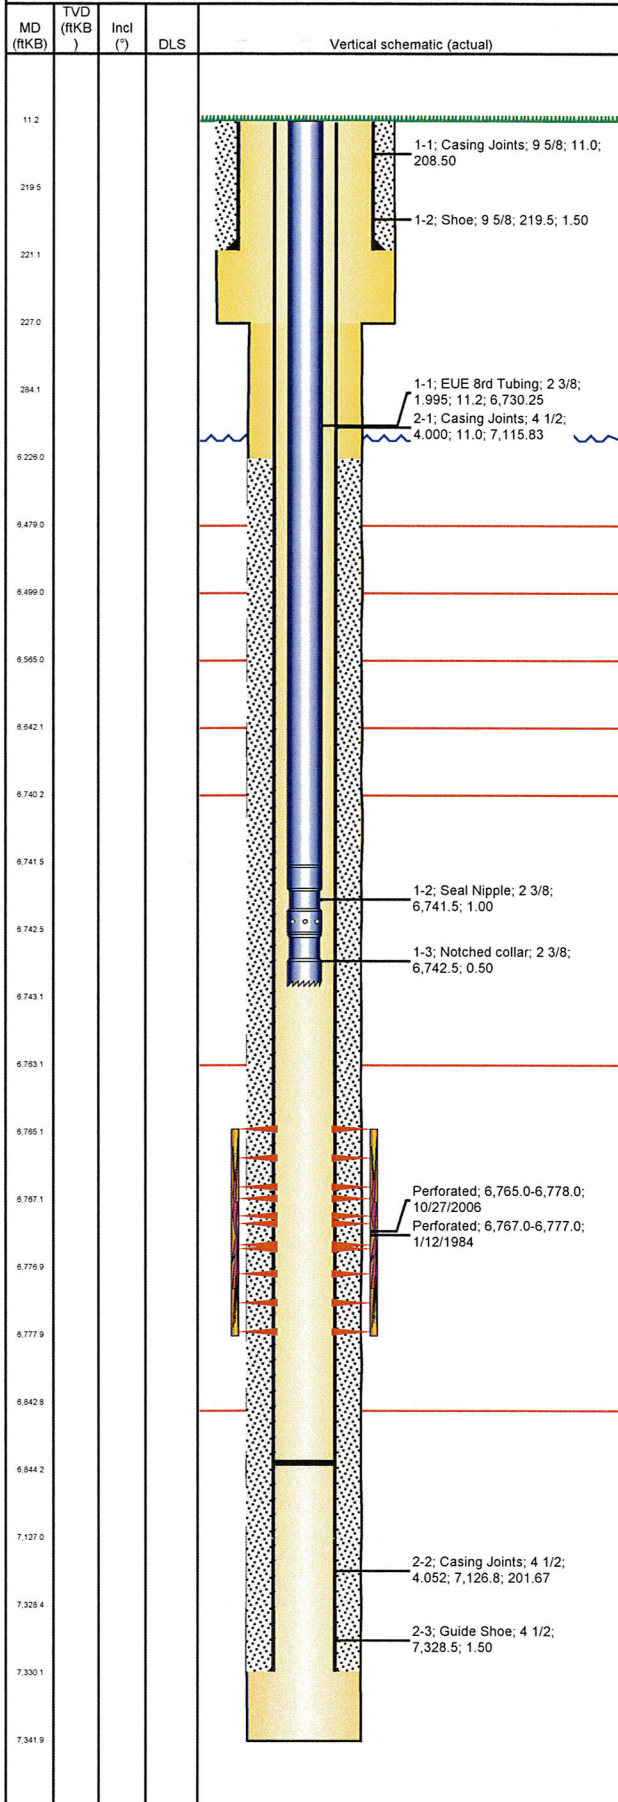

Well Header

API	Business Unit	District	Well Config
05-123-10985	WATTENBERG	15	VERTICAL
Original KB Elevation (ft)	KB - GL / MSL (ftKB)	Spud Date	P & A Date
4,641.00	11.00	1/12/1983	
Comment			
Directions To Well			

Congressional Location

Quarter 1	Quarter 2	Quarter 3	Quarter 4	Section	Township	Twnshp N...	Range	Rng E/W Dir
		SE	SE	10	4	N	64	W

Bottom Hole Location

North-South Distance (ft)	From N or S Line	East-West Distance (ft)	From E or W Line

Plug Back Total Depths

Date	Depth (ftKB)	Method	Com
10/27/2006	7,019.0	CASED HOLE LOG	DEPTH LOGGER - NO ORIG CBL RUN
11/20/2006	6,844.0	TUBING TALLY	TUBING TALLY - DID NOT TAG

Wellbore Sections

Section Des	Size (in)	Act Top (ftKB)	Act Btm (ftKB)
SURFACE	12 1/4	11.0	227.0
PRODUCTION	7 7/8	227.0	7,342.0

Zone Statuses

Zone Name	Status Date	Status	Job
CODELL	1/14/1984	PR	DRILLING/COMPLETION - ORIGINAL, 1/12/1983 00:00
CODELL	2/17/2007	PR	RE-FRAC, 10/24/2006 00:00

Casing Strings

Surface, 221.0ftKB

Casing Description	Run Date	OD (in)	Wt/Len (l...)	Grade	Top (ftKB)	Set Depth...
Surface	1/12/1983	9 5/8	36.00		11.0	221.0

Production, 7,330.0ftKB

Casing Description	Run Date	OD (in)	Wt/Len (l...)	Grade	Top (ftKB)	Set Depth...
Production	1/22/1983	4 1/2	11.60	J-55	11.0	7,330.0

Cement

Description	Top Depth (ftKB)	Bottom Depth (ftKB)
SURFACE CASING CEMENT	11.0	221.0
Description	Top Depth (ftKB)	Bottom Depth (ftKB)
PRODUCTION CASING CEMENT	6,226.0	7,330.0

Tubing Components

Item Des	OD (in)	Wt (lb/ft)	Grade	Jts	Len (ft)	Btm (ftKB)	Btm (TVD) (ftKB)
EUE 8rd Tubing	2 3/8	4.70	J-55	207	6,730.25	6,741.5	
Seal Nipple	2 3/8			1	1.00	6,742.5	
Notched collar	2 3/8			1	0.50	6,743.0	

Perforation Data

Zone	Bnch/St g	Entered Shot Total	Top (ftKB)	Btm (ftKB)	Date
CODELL, ORIGINAL HOLE		52	6,765.00	6,778.00	10/27/2006
CODELL, ORIGINAL HOLE		21	6,767.00	6,777.00	1/12/1984

Stimulations & Treatments

Date	Zone	Primary Job Type
1/13/1984	CODELL, ORIGINAL HOLE	DRILLING/COMPLETION - ORIGINAL
Technical Result		
Tech Result Details		
Tech Result Note		
Comment		

Date	Zone	Primary Job Type
11/15/2006	CODELL, ORIGINAL HOLE	RE-FRAC
Technical Result		
Tech Result Details		
Tech Result Note		
Comment		

Other In Hole

Run Date	Des	OD (in)	Top (ftKB)	Btm (ftKB)

Logs


Date	Type	Top (ftKB)	Btm (ftKB)
1/21/1983	COMPENSATED NEUTRON	6,293.0	7,350.0
1/21/1983	INDUCTION	220.0	7,342.0

Well Name: ADLER 44-10

VERTICAL - ORIGINAL HOLE, 1/21/2013 2:41:54 PM

Logs

					Logs			
		Date	Type	Top (ftKB)	Btm (ftKB)			
		10/27/2006	CBL/CCL/GR	6,100.0	7,019.0			
		12/24/2012	GYRO	11.0	6,740.0			

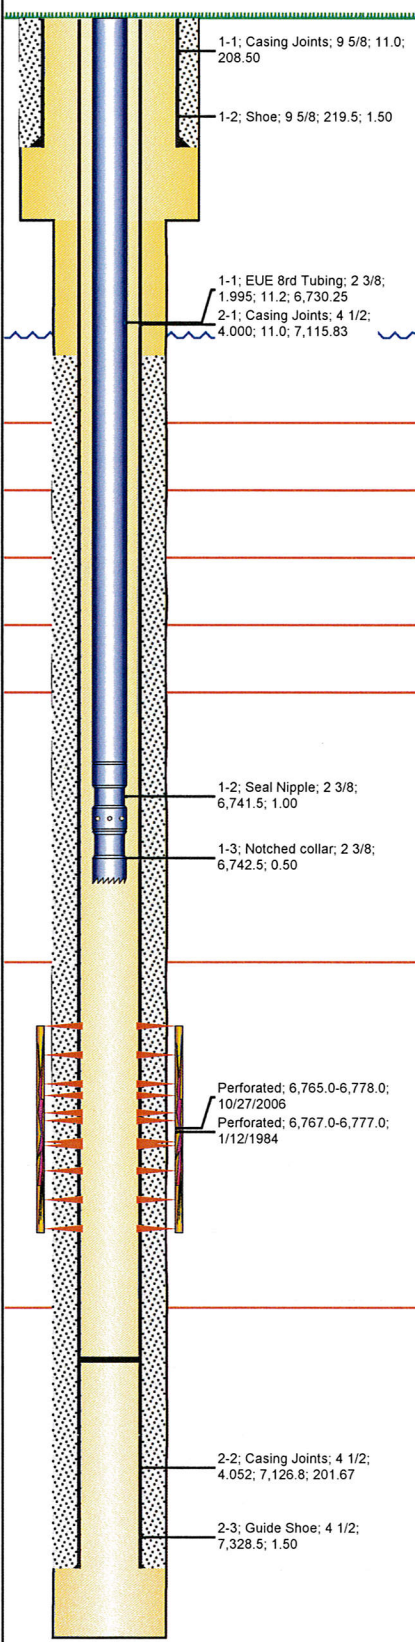MD (ftKB)	TVD (ftKB)	Incl (°)	DLS	Vertical schematic (actual)	Logs
11.2					
219.5					
221.1					
227.0					
284.1					
6,226.0					
6,479.0					
6,499.0					
6,565.0					
6,642.1					
6,740.2					
6,741.5					
6,742.5					
6,743.1					
6,763.1					
6,765.1					
6,767.1					
6,776.9					
6,777.9					
6,842.8					
6,844.2					
7,127.0					
7,328.4					
7,330.1					
7,341.9					