00725803

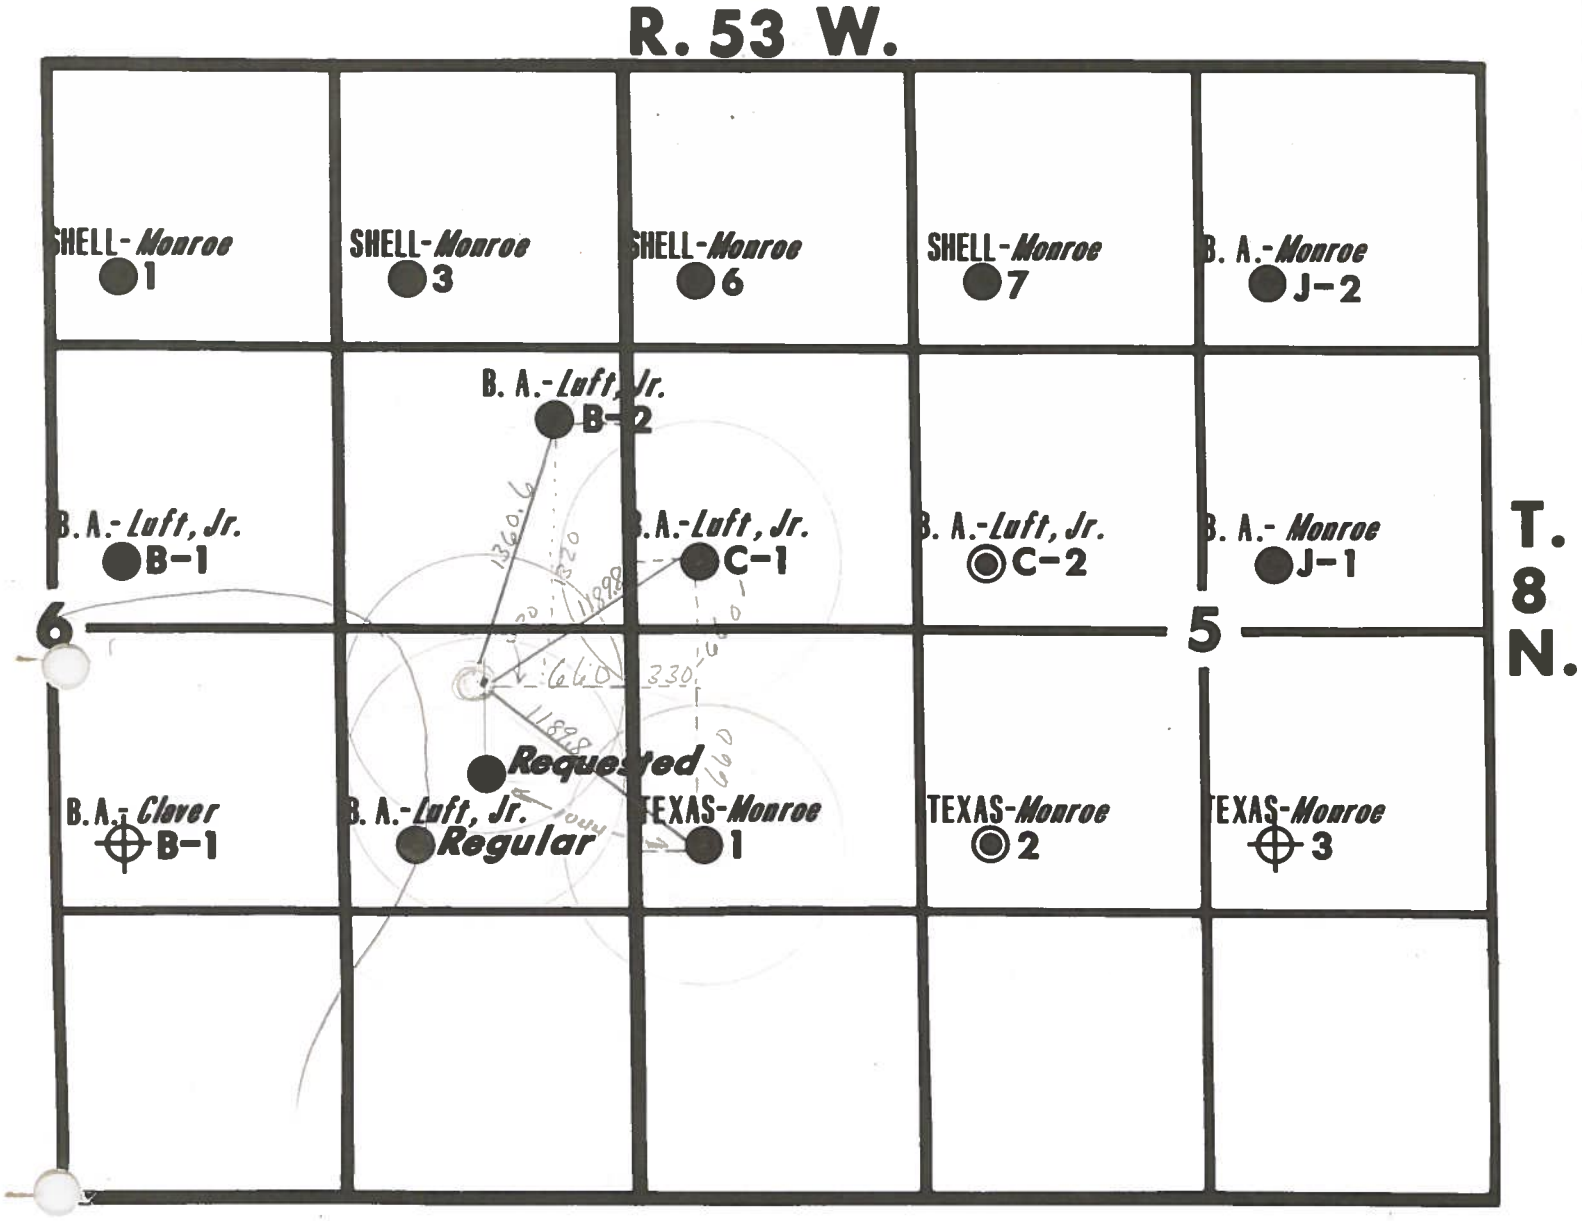

● 'D' Sand Well

◉ 'J' Sand Well

THE TEXAS COMPANY

EXHIBIT I-A

CAUSE NO. 25

Hearing of Feb. 21, 1956

DOMESTIC SERVICE	
Check the class of service desired, otherwise this message will be sent as a fast telegram	
TELEGRAM	
DAY LETTER	
NIGHT LETTER	X

$ S E

WESTERN UNION
TELEGRAM

W. P. MARSHALL, PRESIDENT

1206 (4-55)

INTERNATIONAL SERVICE	
Check the class of service desired; otherwise the message will be sent at the full rate	
FULL RATE	
LETTER TELEGRAM	
SHORE-SHIP	

NO. WDS.-CL. OF SVC.	PD. OR COLL.	CASH NO.	CHARGE TO THE ACCOUNT OF	TIME FILED
	COLLECT			

Send the following message, subject to the terms on back hereof, which are hereby agreed to

DENVER, COLORADO
FEBRUARY 8, 1956

F. A. GRUVER
STANOLIND OIL AND GAS COMPANY
CASPER, WYOMING

HEARINGS SET FOR FEBRUARY 21, 1956, AT TEN A.M., 330 STATE OFFICE BUILDING, DENVER, IN CAUSES NOS. 26 ALENA, 59 LEADER, 78 BUCKINGHAM WEST, 82 ALLEN, 25 NORTHWEST GRAYLIN.

OIL AND GAS CONSERVATION COMMISSION

25