

BUSYGULLY 13-54-12-3

WELL SCHEMATIC

POST-PLUGGING

Surface Loc: NENW Sec 12, T13S, R54W

Lat./Long.: 38.933676° & -103.399755° (Nad 83)


BH Loc: NENW Sec 12, T13S, R54W

TD: 473' MD

County: LINCOLN **State:** COLORADO

TVD: 473' TVD

API# 05-073-06490

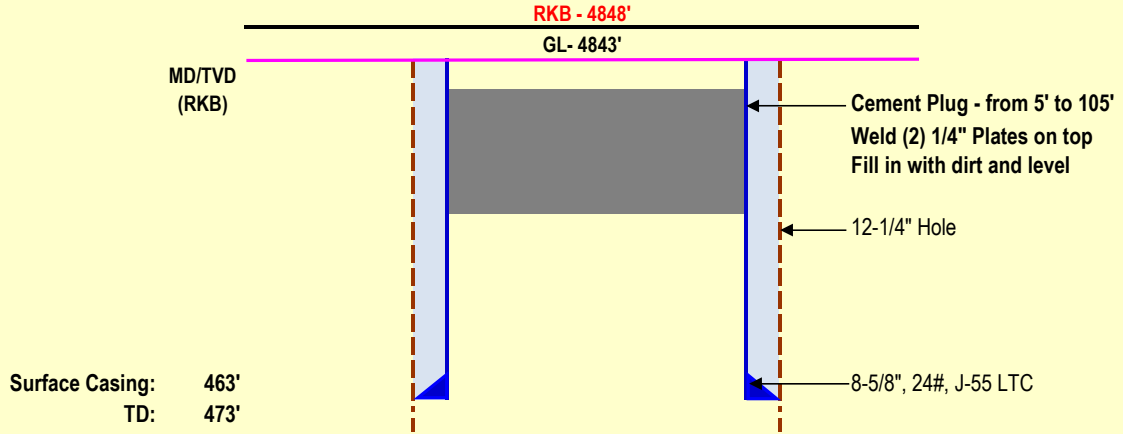

NOT TO SCALE