



Physical Address: 345 Comanche St.
Mail to: Box 384, Kiowa, CO 80117
Ph. 303-621-8672 - Fax 303-621-2717
www.highprairiesurvey.com

Job: 10188 Raptor #5


Inv # 2251

High Prairie Surveying of Kiowa, Colorado has in accordance with a request from **Jack Fincham, Wiepking Fullerton Energy** has determined the location of **Raptor #5** to be **660 feet FNL**, and **1980 feet FEL**, (90° off Section lines) of **SECTION 18**, Township **10s**, Range **55w** of the 6th Principal Meridian, **Lincoln County**, Colorado.


Date: Staked on 12/20/12 drawn on 12/27/12.

Re: Staked by Keith Westfall
Drawn: Drawn by Dustin Cotter

Location Drawing

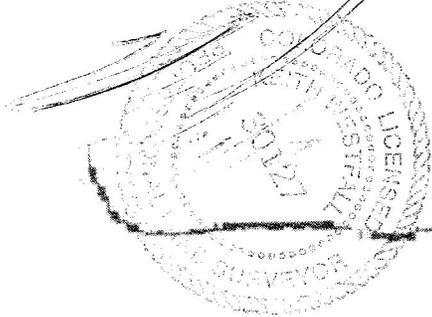

There are no apparent improvements within 400' of the proposed well pad.

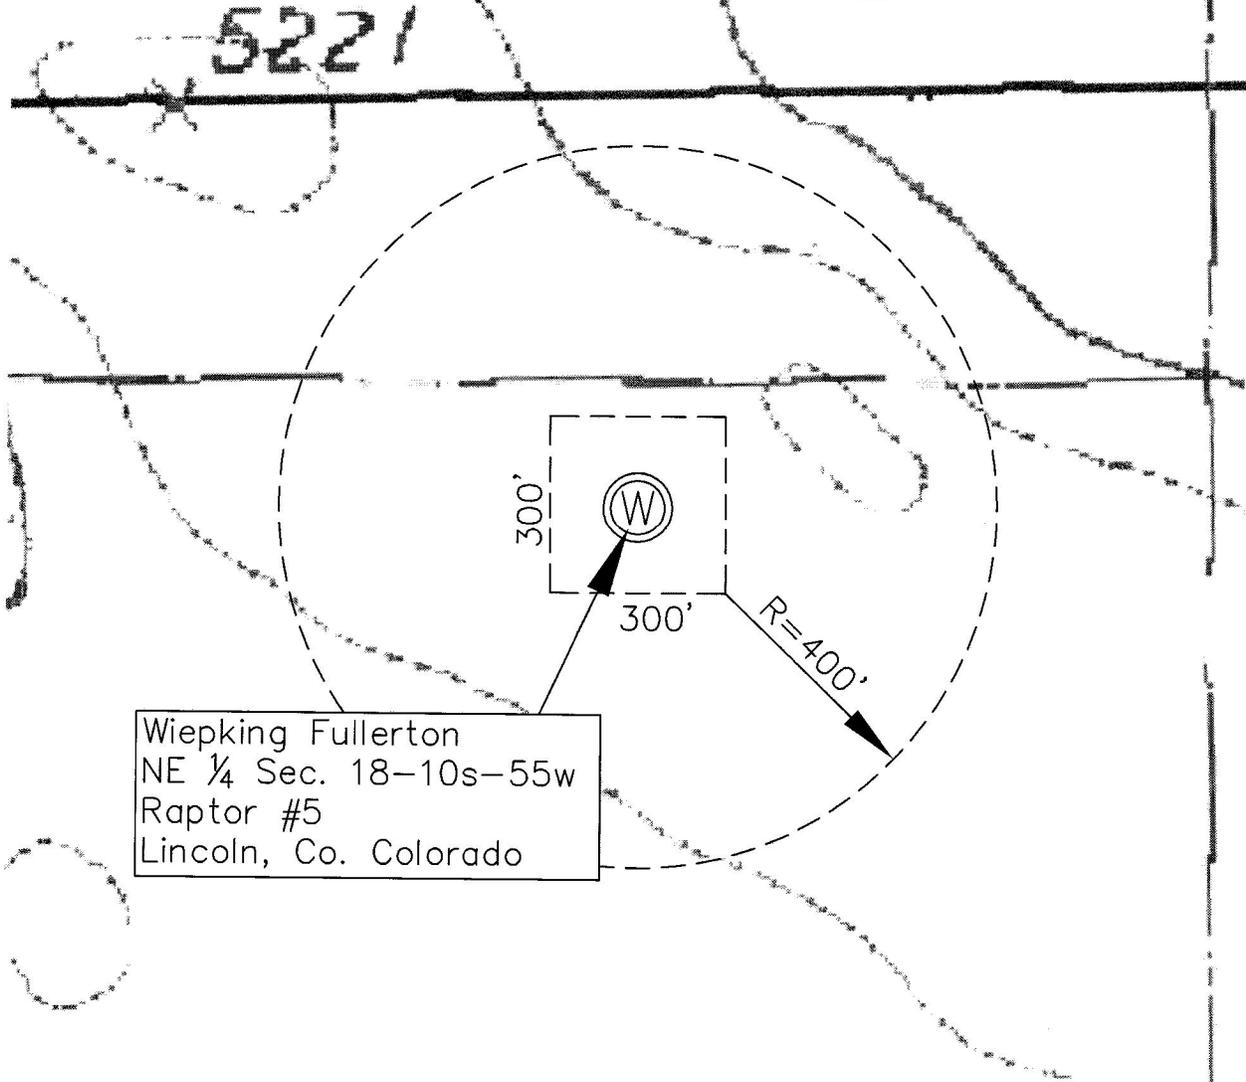

Wiepking Fullerton
NE ¼ Sec. 18-10s-55w
Raptor #5
Lincoln, Co. Colorado