



Company: US ROCKIES REGION
Project: COLORADO-WELD

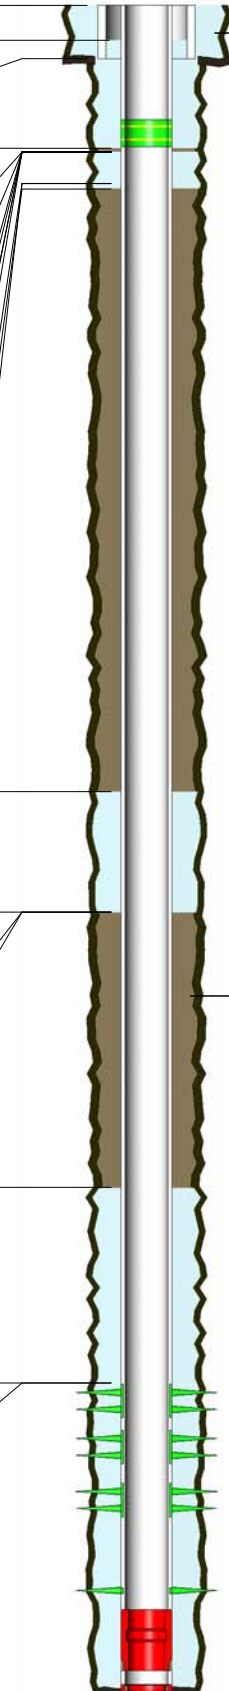
Site: WEICHEL GORDON P UT "B" #1
Common Well Name: WEICHEL GORDON P UT "B" #1

API No: 0512309706
Latitude: 40.137708°
Longitude: -104.632088°

Datum: RKB
Elevation: 4,989.0usft
Water Depth: 4,877.0usft

Section: 14
Township: 2 N
Range: 65 W

Div of Quarter Section: NE
Div of Section: SW

Casing Information	Casing Size & Weight	Cement Fluid (sacks)	Cement Depths (ft)	Schematic (1/31/2013)	Hole Size (in)	MD / PBMD (usft)	Perforation Intervals (usft)
SURFACE CASING - Set @ 300.0usft	8.625in, 4.500in,	, 2.4% CACL2 1/4 #/sk Floc, 250	12 (TOC) 200 (TOC) 300		12.250		660 - 660 - FOX HILLS 830 - 831 - FOX HILLS
		LEAD, NEAT, 20	640				
		LEAD, NEAT, 20	660 (TOC)				
		LEAD, NEAT, 20	660 (TOC)				
		LEAD, NEAT, 20	660 (TOC)				
		LEAD, NEAT, 175	661				
		LEAD, NEAT, 20	661				
			661				
			830 (TOC)				
			831				
			860				
			4120 (TOC)				4,270 - 4,271 - SUSSEX
		LEAD, NEAT, 350					
		, 2% GEL 10% SALT 20% SILIC, 200	4770				
		LEAD, NEAT, 30	4770 (TOC)				4,770 - 4,771 - SUSSEX
			4771				
					7.875		
			6260 (TOC)				
		LEAD, 50/50 POZ-MIX, 110					
			6950 (TOC)				6,930 - 6,931 - NIOBRARA 6,954 - 6,962 - NIOBRARA 7,028 - 7,038 - NIOBRARA 7,142 - 7,158 - CODELL
			6950				
							7,588 - 7,598 - J SAND 7,604 - 7,630 - J SAND
PRODUCTION CASING - Set @ 7,762.0usft	4.500in,		7762			MD: 7,762 PBMD: 7,696	