




DRILLING COMPANY, INC.
WICHITA, KANSAS

Wellbore Diagram

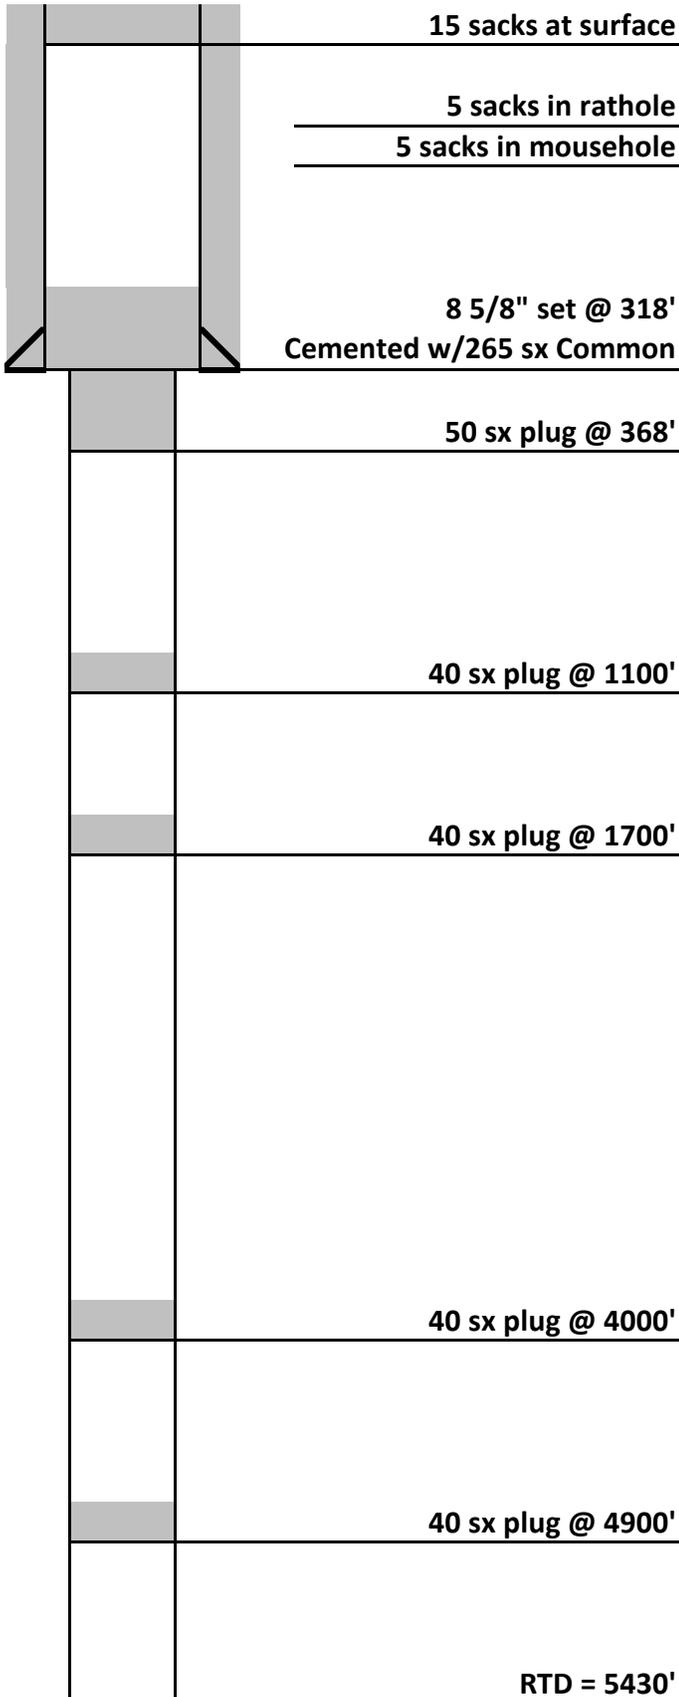

Date:	<u>2/4/2013</u>
Well Name:	<u>Larsen Unit #1-24</u>
Location:	<u>2537' FSL & 823' FWL</u>
	<u>NW/4 SW/4 24-17S-45W</u>
County:	<u>Kiowa</u>
State:	<u>Colorado</u>
API:	<u>05-061-06871-00</u>
Surface Casing:	<u>8 5/8" set @ 318'</u>
Cemented with:	<u>265 sx Common</u>
Total Depth:	<u>5430'</u>
Spud Date:	<u>12/27/2012</u>
P&A Date:	<u>1/9/2013</u>

<u>LOG TOPS</u>	<u>DEPTH</u>
Shawnee	3786
Heebner Shale	3995
Lansing	4026
Marmaton	4450
Ft. Scott	4560
Cherokee Shale	4630
Atoka	4796
Morrow Shale	4950
Mississippian	5148