


Well Name: BELL L12-24

VERTICAL - ORIGINAL HOLE, 2/6/2013 1:08:10 PM

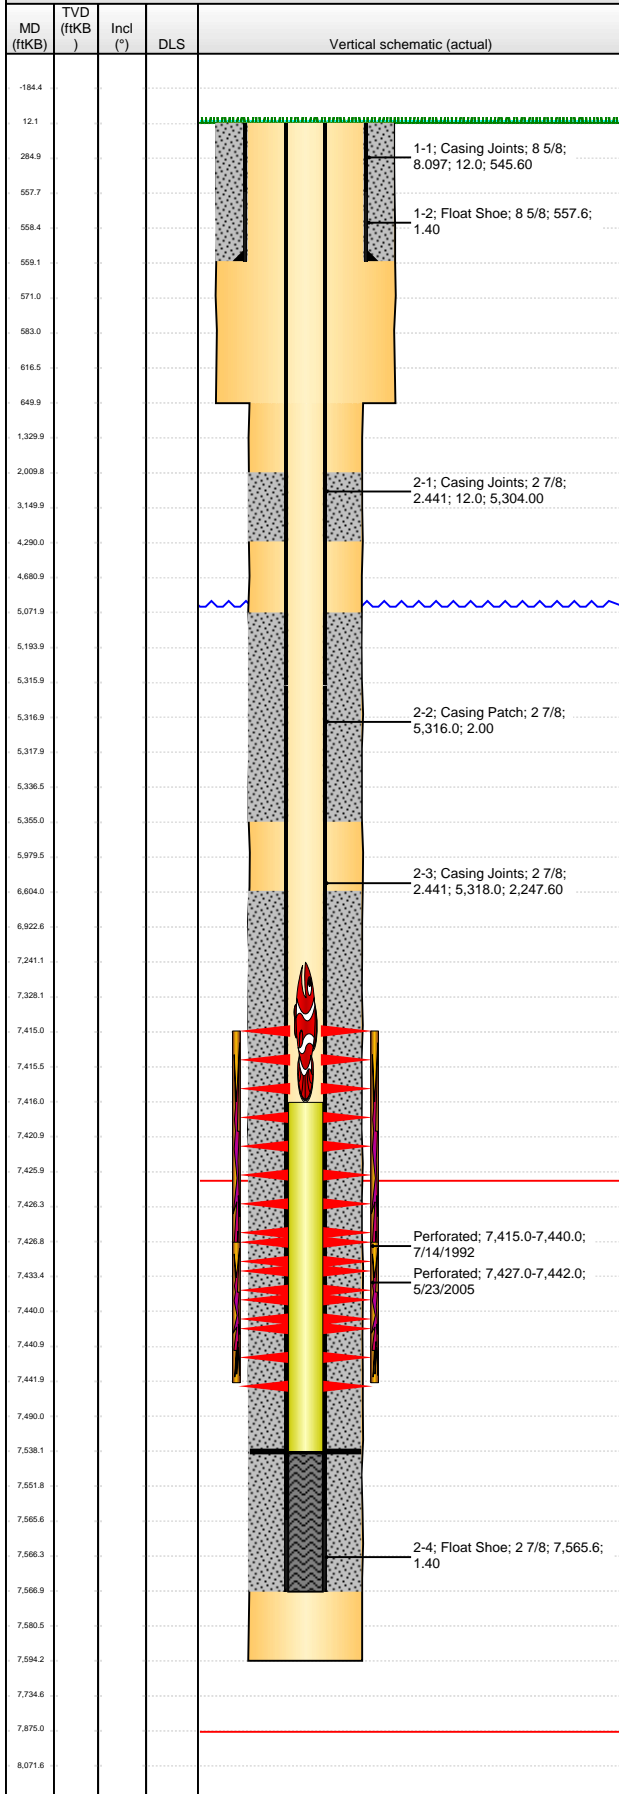

Well Header

| | | | |
|--|-------------------------------|------------------------|-------------------------|
| API 05-123-15853 | Business Unit WATTENBERG | District 15 | Well Config VERTICAL |
| Original KB Elevation (ft) 4,997.00 | KB - GL / MSL (ftKB) 12.00 | Spud Date 6/30/1992 | P & A Date |

Comment
patch @ 5316 5/05, 300 sxs cmt. LEFT 2 CHEMICAL GUNS IN HOLE AND ON TOP OF FISH. WE DO NOT KNOW IF THE 1ST GUN WENT OFF.

Directions To Well
WCR 35 & WCR 34: EAST 2/10, NORTH 2/10 TO BATTERY, EAST INTO

Congressional Location

| | | | | | | | | |
|-----------|-----------|-----------|-----------|---------|----------|-------------|-------|-------------|
| Quarter 1 | Quarter 2 | Quarter 3 | Quarter 4 | Section | Township | Twnshp N... | Range | Rng E/W Dir |
| | | | S2 | 12 | 3 | N | 66 | W |

Bottom Hole Location

| | | | |
|---------------------------|------------------|-------------------------|------------------|
| North-South Distance (ft) | From N or S Line | East-West Distance (ft) | From E or W Line |
|---------------------------|------------------|-------------------------|------------------|

Plug Back Total Depths

| Date | Depth (ftKB) | Method | Com |
|----------|--------------|--------|-----|
| 7/5/1992 | 7,538.0 | TAG | |

Wellbore Sections

| Section Des | Size (in) | Act Top (ftKB) | Act Btm (ftKB) |
|-------------|-----------|----------------|----------------|
| SURFACE | 12 1/4 | 12.0 | 650.0 |
| PRODUCTION | 7 7/8 | 650.0 | 7,594.0 |

Zone Statuses

| Zone Name | Status Date | Status | Job |
|-----------|-------------|--------|---|
| CODELL | 8/10/1992 | PR | DRILLING/COMPLETION - ORIGINAL, 6/30/1992 00:00 |
| CODELL | 6/15/2005 | PR | RE-FRAC, 3/29/2005 00:00 |

Casing Strings

| Surface, 559.0ftKB | | | | | | |
|--------------------|-----------|---------|---------------|-------|------------|--------------|
| Casing Description | Run Date | OD (in) | Wt/Len (l...) | Grade | Top (ftKB) | Set Depth... |
| Surface | 6/30/1992 | 8 5/8 | 24.00 | J-55 | 12.0 | 559.0 |

Production, 7,567.0ftKB

| Casing Description | Run Date | OD (in) | Wt/Len (l...) | Grade | Top (ftKB) | Set Depth... |
|--------------------|----------|---------|---------------|-------|------------|--------------|
| Production | 7/6/1992 | 2 7/8 | 6.50 | N-80 | 12.0 | 7,567.0 |

Cement

| Description | Top Depth (ftKB) | Bottom Depth (ftKB) |
|--------------------------|------------------|---------------------|
| SURFACE CASING CEMENT | 12.0 | 559.0 |
| PRODUCTION CASING CEMENT | 6,604.0 | 7,567.0 |
| Remedial Casing Cement | 2,010.0 | 4,290.0 |
| Remedial Casing Cement | 5,072.0 | 5,355.0 |

Tubing Components

| Item Des | OD (in) | Wt (lb/ft) | Grade | Jts | Len (ft) | Btm (ftKB) | Btm (TVD) (ftKB) |
|----------|---------|------------|-------|-----|----------|------------|------------------|
|----------|---------|------------|-------|-----|----------|------------|------------------|

Perforation Data

| Zone | Bnch/St g | Entered Shot Total | Top (ftKB) | Btm (ftKB) | Date |
|-----------------------|-----------|--------------------|------------|------------|-----------|
| CODELL, ORIGINAL HOLE | | 49 | 7,415.00 | 7,440.00 | 7/14/1992 |
| CODELL, ORIGINAL HOLE | | 60 | 7,427.00 | 7,442.00 | 5/23/2005 |

Stimulations & Treatments

| Date | Zone | Primary Job Type |
|-----------|-----------------------|--------------------------------|
| 7/19/1992 | CODELL, ORIGINAL HOLE | DRILLING/COMPLETION - ORIGINAL |

| Technical Result | Tech Result Details | Tech Result Note |
|------------------|---------------------|------------------|
|------------------|---------------------|------------------|

Comment

| Date | Zone | Primary Job Type |
|-----------|-----------------------|------------------|
| 6/14/2005 | CODELL, ORIGINAL HOLE | RE-FRAC |

| Technical Result | Tech Result Details | Tech Result Note |
|------------------|---------------------|------------------|
|------------------|---------------------|------------------|


Comment

Other In Hole

| Run Date | Des | OD (in) | Top (ftKB) | Btm (ftKB) |
|-----------|-----------|---------|------------|------------|
| 7/23/2010 | Sand plug | 2.441 | 7,416.0 | 7,538.0 |
| 7/23/2010 | FISH | 1.66 | 7,241.0 | 7,416.0 |

Well Name: BELL L12-24

VERTICAL - ORIGINAL HOLE, 2/6/2013 1:08:11 PM

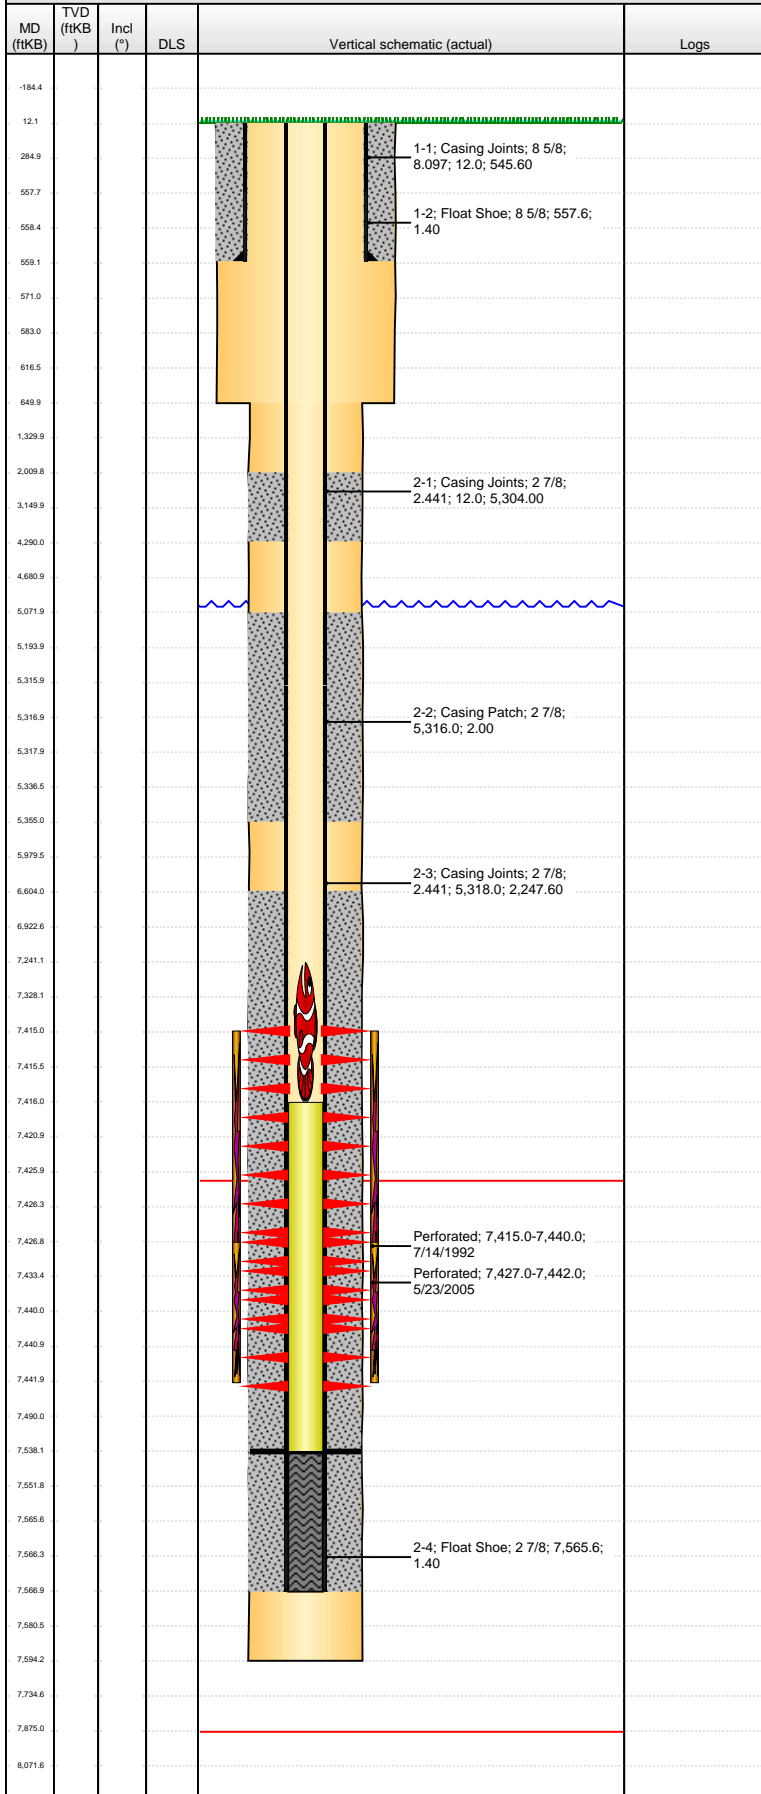

| Logs | | | |
|-----------|---------------------|------------|------------|
| Date | Type | Top (ftKB) | Btm (ftKB) |
| 7/6/1992 | COMPENSATED DENSITY | 6,730.0 | 7,560.0 |
| 7/14/1992 | CBL/CCL/GR | 6,520.0 | 7,507.0 |