




JR Land Surveying, LLC  
 8114 Northstar Drive  
 Windsor, Colorado 80528  
 P. 970-576-4641

# WELL LOCATION CERTIFICATE

*THIS MAP DOES NOT REPRESENT A BOUNDARY SURVEY*

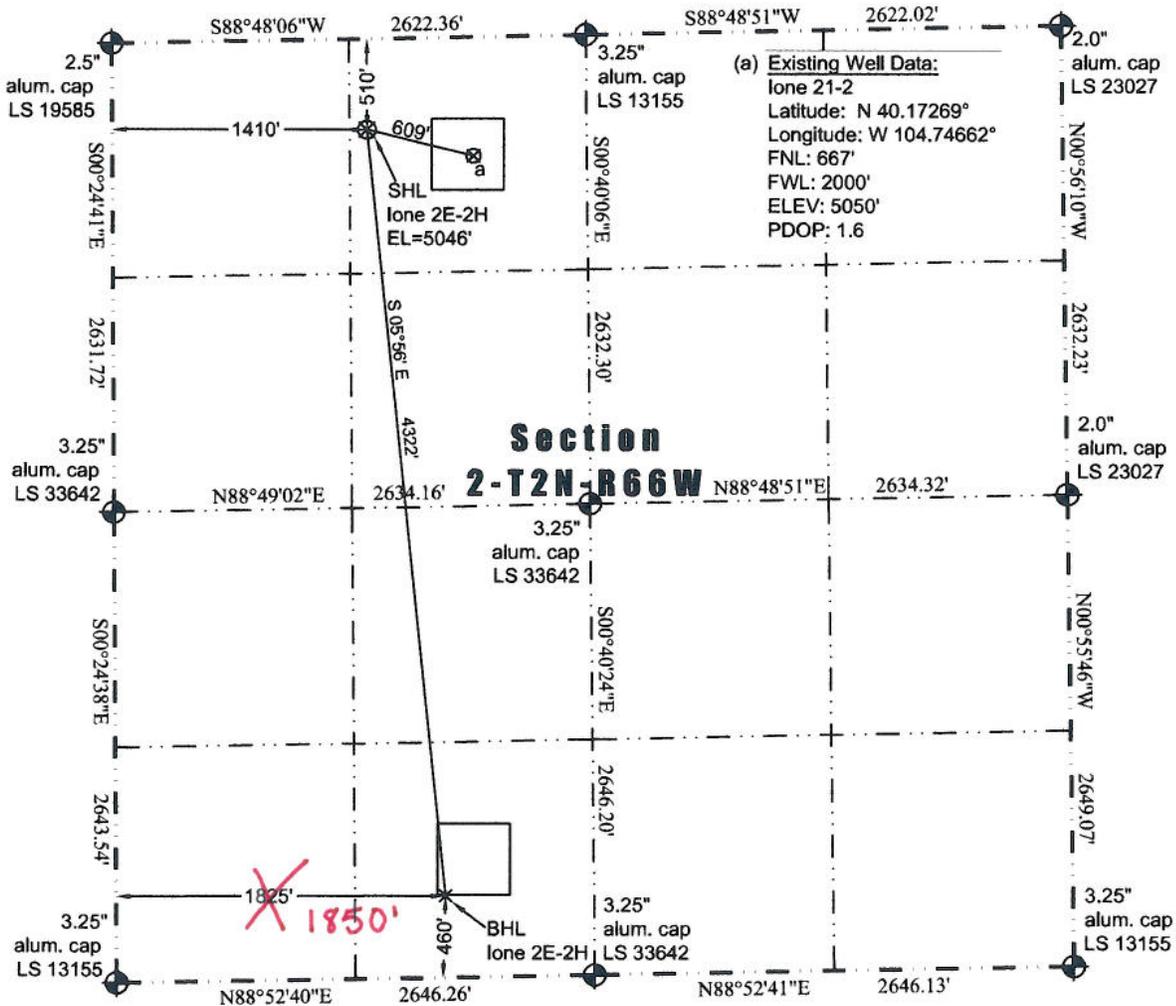

(a) **Existing Well Data:**  
 lone 21-2  
 Latitude: N 40.17269°  
 Longitude: W 104.74662°  
 FNL: 667'  
 FWL: 2000'  
 ELEV: 5050'  
 PDOP: 1.6

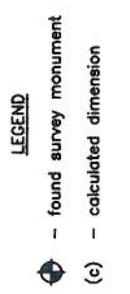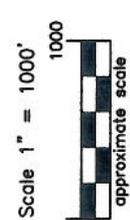

In accordance with a request from Jay Knutson of EnCana Oil & Gas (USA) Inc., JR Land Surveying, LLC has determined the location of the lone 2E-2H well site to be SHL 510' FNL and 1410' FWL (BHL 460' FSL and 1825' FWL) as measured at ninety (90) degrees from the section lines of Section 2, Township 2 North, Range 66 West of the 6th Principal Meridian, Weld County, Colorado.

**Proposed Surface Hole Data:**

Latitude: N 40.17311° (BHL 40.16129°)  
 Longitude: W 104.74873° (BHL 104.74726°)  
 PDOP: 1.7

**Nearest:**

Building 2,818' northwest	Above Ground Utility 1,477' northwest
Public Road 1,501' northwest	Railroad 18,516' southwest
Property Line 510' north	Well Window: SHL is 360' outside
Existing Well: lone 21-2, 609' southeast	

**Notes:**

- 1) Bearings and distances based on NAD 83 Colorado North State Plane Coordinates using RTK GPS observations taken 7/27/12 by operator John Rice.
- 2) Conversion factor to ground (1.000275398).
- 3) Elevations based on NAVD 88 GPS heights and Geoid 2003 corrections.
- 4) See Location Drawing for visible improvements within 400 feet.
- 5) The surface use is agricultural rangeland.

**NOTICE:** According to Colorado law you must commence any legal action based upon any defect in this W.L.C. within three years after you first discover such defect. In no event may any action based upon any defect in this W.L.C. be commenced more than ten years from this said date of the certification shown hereon.

I hereby certify that this Well Location Certificate was prepared by me or under my direct supervision on 7/29/2012 for and on behalf of EnCana Oil & Gas (USA) Inc. That it is not a Land Survey Plat or an Improvement Survey Plat and that it is not to be relied upon for establishment of fences, buildings, or other future improvement lines.



John Robert McGeorge LS#38219  
 Well: lone 2E-2H WLC