

WELL LOCATION CERTIFICATE


WASTE MGMT 2i-401

THIS MAP DOES NOT REPRESENT A BOUNDARY SURVEY

SECTION: 2
TOWNSHIP: 2N
RANGE: 64W

FOUND 2 3/8" PIPE
WITH 3 1/4" ALUM CAP
STAMPED "LS 2279 1980"
LAT=40.17465N
LONG=104.50940W

FOUND #6 REBAR
WITH 3 1/4" ALUM CAP
STAMPED "LS 16154"
LAT=40.17463N
LONG=104.52819W

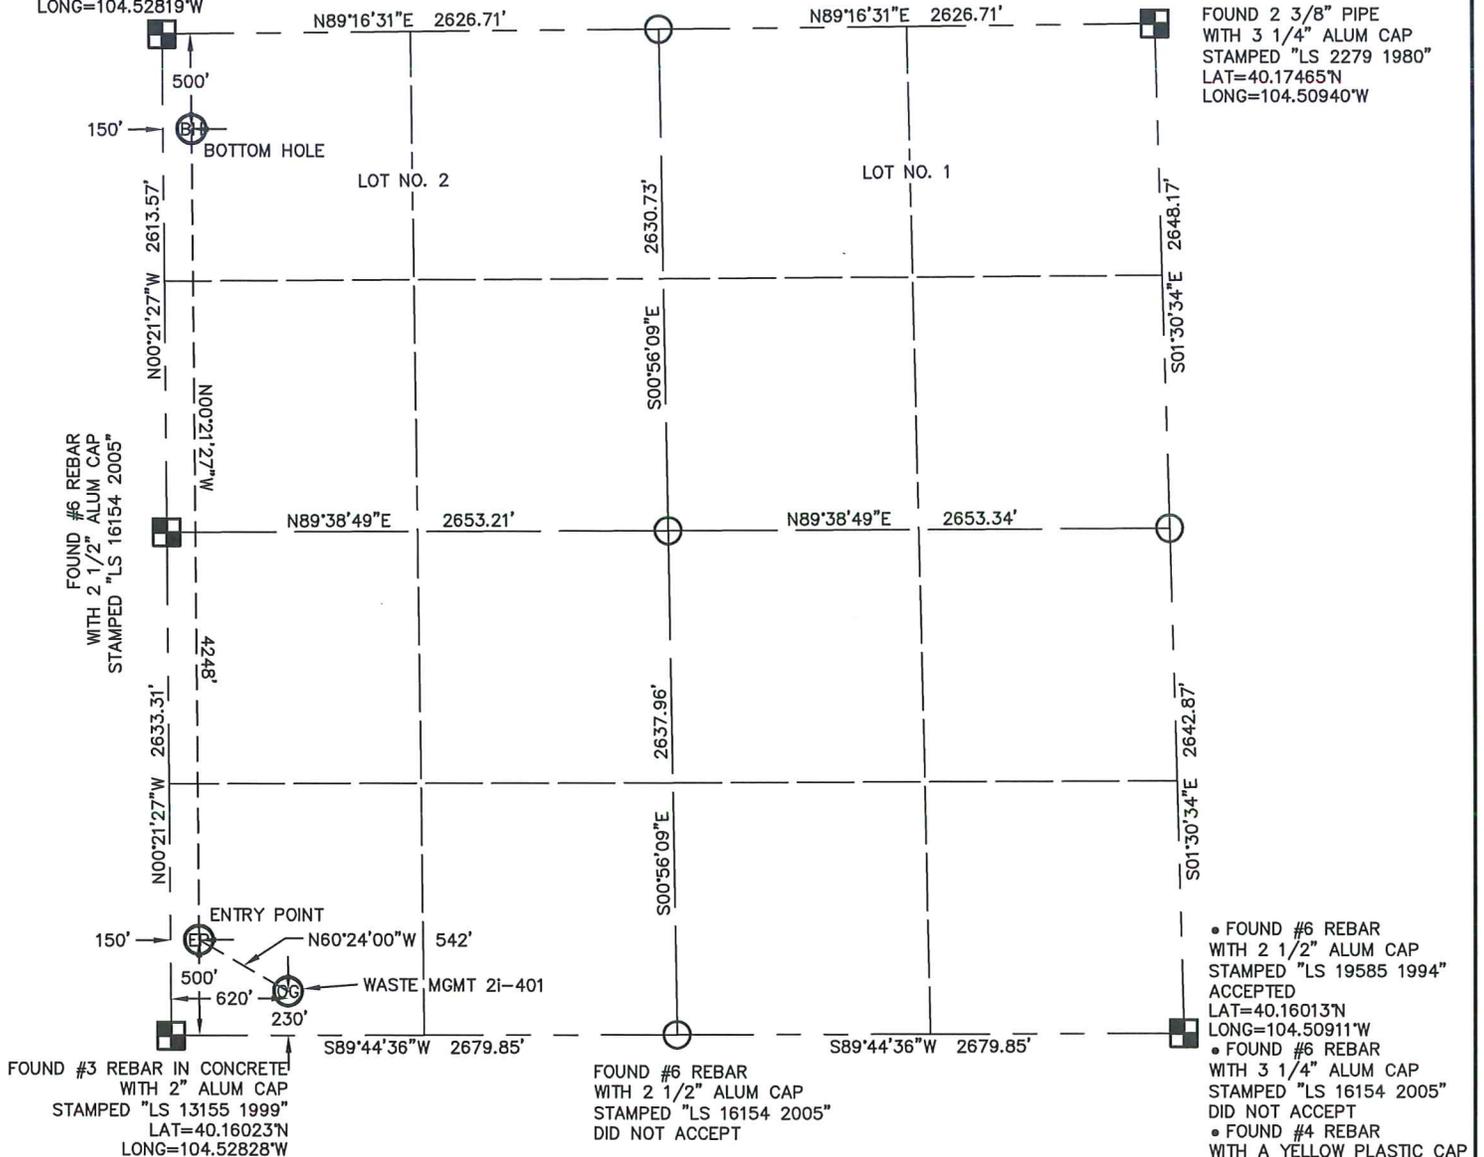

- FOUND #6 REBAR WITH 2 1/2" ALUM CAP STAMPED "LS 19585 1994" ACCEPTED
LAT=40.16013N
LONG=104.50911W
- FOUND #6 REBAR WITH 3 1/4" ALUM CAP STAMPED "LS 16154 2005" DID NOT ACCEPT
- FOUND #4 REBAR WITH A YELLOW PLASTIC CAP STAMPED "LS 2682" DID NOT ACCEPT

In accordance with a request from MAC NEUMANN with PDC ENERGY, INC.

King Surveyors Inc. has determined the surface location of the WASTE MGMT 2i-401 to be 230' from the SOUTH line and 620' from the WEST line, the entry point to be 500' from the SOUTH line and 150' from the WEST line and the bottom hole to be 500' from the NORTH line and 150' from the WEST line, as measured at right angles, from the section lines of Section 2, Township 2 North, Range 64 West of the Sixth Principal Meridian, County of Weld, State of Colorado.

I hereby state that this Well Location Certificate was prepared by me, or under my direct supervision, that the fieldwork was completed on 12-7-2012, for and on behalf of PDC ENERGY, INC., that this is not a Land Survey Plat or an Improvement Survey Plat, and that it is not to be relied upon for establishment of fence, building, or other future improvement lines.

SURFACE LOCATION
LATITUDE: 40.16085N
LONGITUDE: 104.52606W
PDOP: 2.1
ELEV: 4939'
1/4, 1/4: SW 1/4 SW 1/4
NEAREST PROPERTY LINE: ±2900' SOUTH

ENTRY POINT
LATITUDE: 40.16160N
LONGITUDE: 104.52774W
BOTTOM HOLE
LATITUDE: 40.17325N
LONGITUDE: 104.52767W

NOTES:

- 1) Bearings shown are Grid Bearings of the Colorado State Plane Coordinate System, North Zone, North American Datum 1983/2007. The lineal dimensions as contained herein are based upon the "U.S. Survey Foot."
- 2) Ground elevations are based on an observed GPS elevation (NAVD 1988 DATUM).
- 3) NEAREST EXISTING WELL: NO EXISTING WELLS IN THIS SECTION
- 4) IMPROVEMENTS: See LOCATION DRAWING for all visible improvements within 400' of the disturbed area.
- 5) SURFACE USE: PASTURE/PRAIRIE
- 6) FIELD OPERATOR: RON EDWARDS

LEGEND

- = FOUND ALIQUOT MONUMENT AS DESCRIBED
- = CALCULATED POSITION
- = SET ALIQUOT MONUMENT AS DESCRIBED


NOTE

According to Colorado law, you must commence any legal action based upon any defect in this W.L.C. within three years after you discover such defect. In no event, may any action based upon any defect in this survey be commenced more than ten years after the date of the certificate shown hereon. (13-80-105 C.R.S.)

Michael Chad Dilka - On Behalf Of King Surveyors, Inc.
Colorado Licensed Professional Land Surveyor #38106
1/2/2013
PROJECT#: 2012372

SITE SKETCH
WASTE MGMT 2i-401

SECTION: 2
TOWNSHIP: 2N
RANGE: 64W

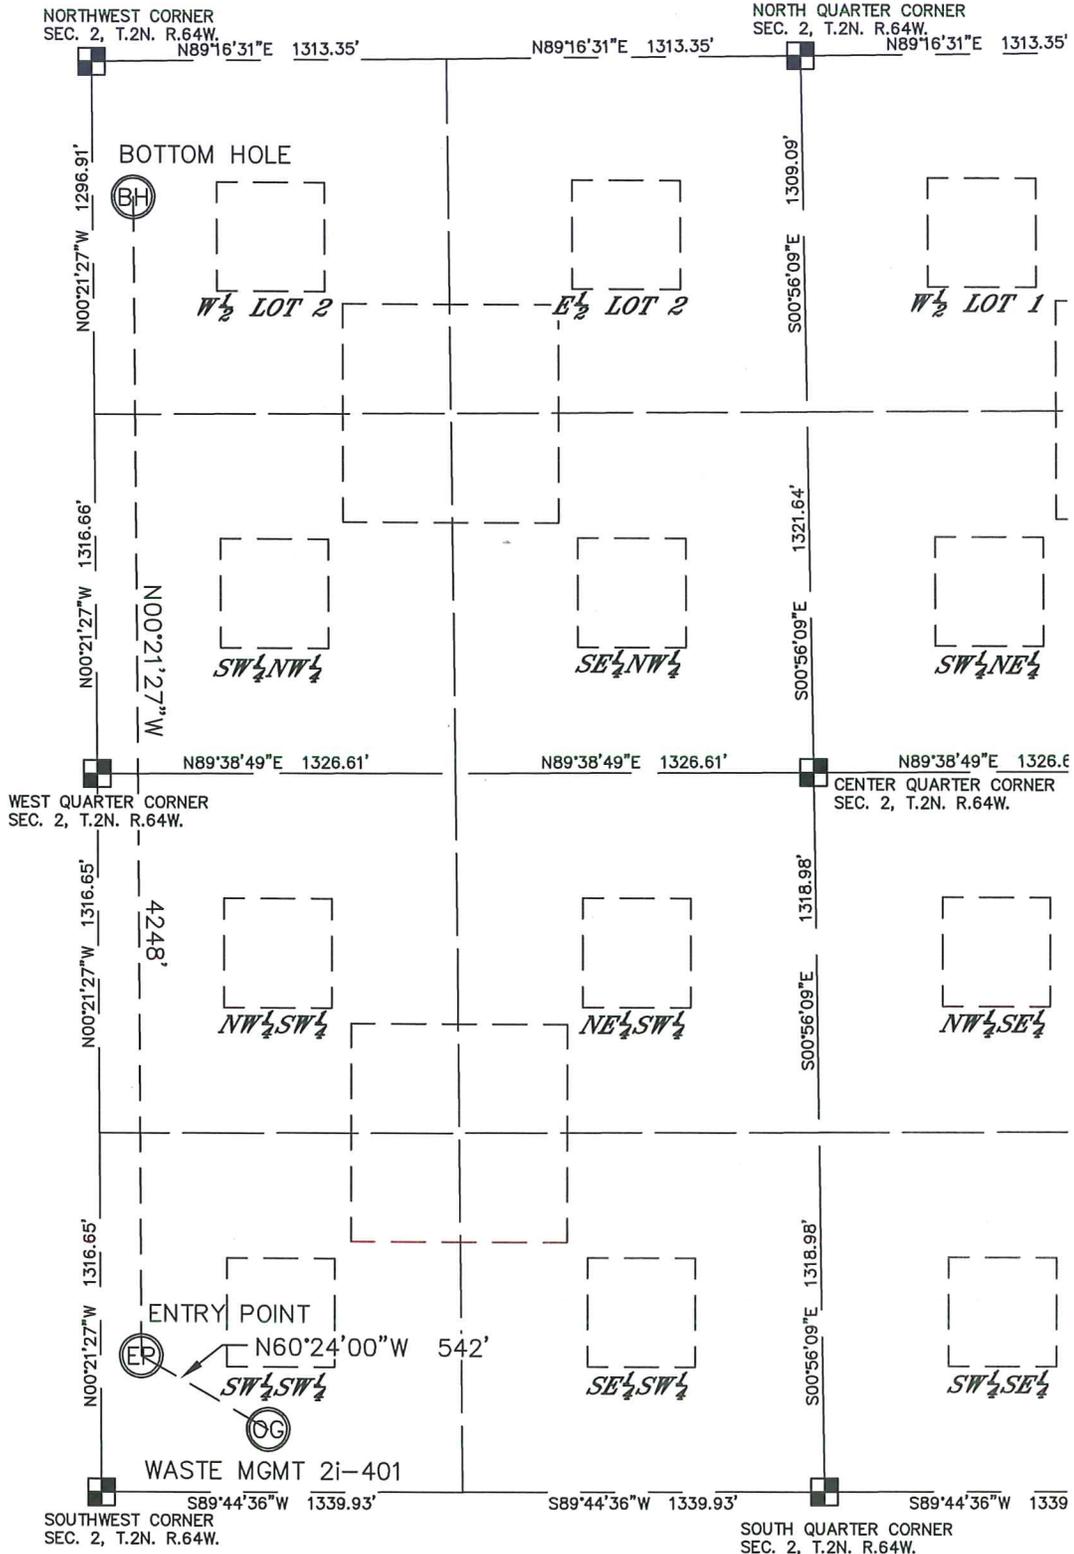

NOTE
THERE ARE NO EXISTING WELLS IN THIS SECTION.

