


Vernal

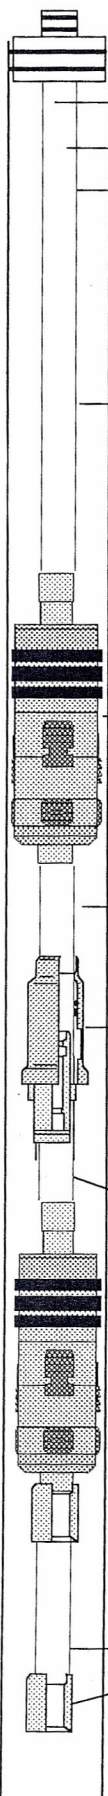

COMPANY: CHEVRON USA INC.		CASING	LINER	TUBING	TAILPIPE
1	WELL NUMBER: FEE 162Y	SIZE	7"	2 7/8	2 7/8"
2	FIELD/LEASE: RWSU	WEIGHT	23#	7.3#	
3	COUNTY: RIO BLANCO	GRADE	L-80	F.L.	FGW
	STATE: COLORADO	THREAD		EUE 8 rd	
	DATE: 31-Jan-13	DEPTH	6667'	6070'	
ITEM	DESCRIPTION	O.D.	I.D.	LENGTH	DEPTH
	Well Type WAG INJECTOR	END OF TAILPIPE			6220.22'
	KBTH			22.00	
	COMPRESSION 10,000#			-1.50	22.00
1	1 JT 2 7/8" F.L. PXP NEW	3.130	2.125	31.28	20.50
2	10' X 2 7/8" F.L. PUP NEW	3.668	2.125	10.23	51.78
3	2' X 2 7/8" F.L. PUP NEW	3.668	2.125	1.86	62.01
4	190 JNTS 2 7/8" F.L. NEW	3.668	2.125	6070.10	63.87
5	7" PSI-X RHS-RHR COATED I&E CARBIDES	6.000	2.401	7.45	6133.97
6	1 JNT 2 7/8" FGW-F.L. NEW	3.801	2.125	31.72	6141.42
7	2 7/8" EXTN ON/OFF W/ 1.875F S.S. SLICK	5.500	1.875	4.65	6173.14
8	6' X 2 7/8" FGW-F.L. PUP NEW	3.801	2.125	6.25	6177.79
9	7" LOC-SET PKR COATED I&E CARBIDES	6.078	2.401	4.00	6184.04
10	1 JT 2 7/8" FGW- TK15 ID NEW	3.801	2.401	31.80	6188.04
11	2 7/8" WIRELINE ENTRY GUIDE 316 S.S.	3.668	2.500	0.38	6219.84
					6220.22
7	PKR FLUID: 2 DRUMS KW-132 MIX W/ FRESH				
	TBG RAN WITH 1200 FT/LBS TORQUE & SEAL LUBE				
	TBG LANDED W/ 10,000# COMPRESSION				
8	TBG TESTED @ 2500 PSI				
	CASING TESTED @ 1200 PSI				
9	9 5/8" #36 K-55 0'-2011'				
	7" 23# L-80 0'-6667'				
	PERFS - 6242'-6410'				
	PBTD -6642'				

Prepared for: MR. BRENT SWANK

BY: GARY L. WORKMAN

MILLER PUMPS / PACKERS
1161 E. 1300 S. VERNAL UT.
435-789 0666

ELWF
2/15/13
DUP