

Noble Energy

Weld County, CO (NAD 83)

Sec. 25-T6N-R63W (Wells Ranch 26 PAD)

Wells Ranch AA26-67-1HN - A3

Design: MWD Survey

Sperry Drilling Services Final Survey Report

02 January, 2013

Well Coordinates: 1,412,974.80 N, 3,307,721.64 E (40° 27' 42.30" N, 104° 23' 38.69" W)
Ground Level: 4,819.00 ft

Local Coordinate Origin:	Centered on Well Wells Ranch AA26-67-1HN - Slot A
Viewing Datum:	KB @ 4843.00ft (H&P 315)
TVDs to System:	N
North Reference:	Grid
Unit System:	API - US Survey Feet - Custom

Geodetic Scale Factor Applied

Version: 2003.16 Build: 431

HALLIBURTON

Design Report for Wells Ranch AA26-67-1HN - MWD Survey

Measured Depth (ft)	Inclination (°)	Azimuth (°)	Vertical Depth (ft)	+N/-S (ft)	+E/-W (ft)	Vertical Section (ft)	Dogleg Rate (°/100ft)
0.00	0.00	0.00	0.00	0.00	0.00	0.00	0.00
578.00	0.00	0.00	578.00	0.00	0.00	0.00	0.00
Surface Casing Assumed Vertical at 578.00ft							
617.00	0.99	305.46	617.00	0.20	-0.27	0.25	2.54
First MWD Survey							
893.00	0.83	331.69	892.96	3.34	-3.16	2.81	0.16
1,173.00	0.94	284.45	1,172.93	5.70	-6.35	5.75	0.26
1,459.00	0.65	287.63	1,458.91	6.77	-10.17	9.44	0.10
1,554.00	1.48	250.74	1,553.89	6.53	-11.84	11.13	1.09
1,649.00	2.35	221.24	1,648.84	4.66	-14.28	13.74	1.36
1,744.00	3.96	216.17	1,743.69	0.55	-17.50	17.36	1.72
1,840.00	5.53	212.77	1,839.36	-6.02	-21.96	22.46	1.66
1,935.00	8.17	211.62	1,933.67	-15.61	-27.98	29.41	2.78
2,030.00	9.72	204.26	2,027.52	-28.68	-34.82	37.52	2.02
2,125.00	9.90	201.52	2,121.13	-43.58	-41.11	45.27	0.53
2,220.00	12.30	204.76	2,214.35	-60.37	-48.34	54.15	2.61
2,316.00	13.76	205.69	2,307.87	-79.95	-57.57	65.30	1.54
2,411.00	14.93	200.28	2,399.91	-101.61	-66.71	76.57	1.87
2,506.00	14.72	199.29	2,491.75	-124.48	-74.94	87.05	0.35
2,601.00	16.43	205.64	2,583.27	-147.99	-84.74	99.16	2.54
2,697.00	14.57	204.36	2,675.77	-171.23	-95.60	112.29	1.97
2,792.00	14.75	205.83	2,767.68	-193.00	-105.80	124.62	0.44
2,887.00	15.25	200.95	2,859.44	-215.56	-115.54	136.57	1.43
2,982.00	14.87	200.91	2,951.18	-238.61	-124.35	147.66	0.40
3,077.00	14.98	199.09	3,042.98	-261.60	-132.72	158.29	0.51
3,173.00	13.09	199.93	3,136.11	-283.55	-140.48	168.21	1.98
3,268.00	14.42	198.91	3,228.38	-304.85	-147.98	177.81	1.42
3,363.00	12.60	202.16	3,320.75	-325.64	-155.73	187.60	2.08
3,458.00	12.79	204.01	3,413.43	-344.84	-163.91	197.67	0.47
3,554.00	13.46	207.88	3,506.92	-364.43	-173.46	209.14	1.15
3,649.00	12.01	205.68	3,599.58	-383.11	-182.92	220.42	1.61
3,744.00	11.91	203.74	3,692.52	-400.99	-191.15	230.40	0.44
3,839.00	13.53	204.29	3,785.19	-420.09	-199.67	240.79	1.71
3,935.00	13.78	202.09	3,878.47	-440.92	-208.58	251.76	0.60
4,030.00	11.67	205.69	3,971.14	-460.07	-217.01	262.05	2.37
4,125.00	8.85	200.58	4,064.61	-475.57	-223.74	270.31	3.12
4,220.00	6.40	211.42	4,158.77	-486.93	-229.07	276.75	2.98
4,315.00	3.28	201.55	4,253.42	-493.98	-232.83	281.20	3.39
4,411.00	2.04	176.81	4,349.31	-498.24	-233.74	282.54	1.73
4,506.00	1.62	45.68	4,444.29	-498.99	-232.69	281.56	3.51
4,601.00	2.42	43.12	4,539.23	-496.59	-230.36	279.00	0.85
4,696.00	2.87	47.70	4,634.13	-493.53	-227.23	275.58	0.52
4,791.00	3.06	52.31	4,729.00	-490.37	-223.46	271.52	0.32
4,887.00	3.69	44.53	4,824.84	-486.61	-219.27	266.97	0.81
4,982.00	1.12	315.82	4,919.77	-483.76	-217.77	265.19	4.03
5,267.00	0.62	313.95	5,204.73	-480.69	-220.82	267.92	0.18
5,553.00	0.90	92.64	5,490.72	-479.72	-219.69	266.70	0.50
5,912.00	1.37	104.35	5,849.65	-480.91	-212.72	259.88	0.15
5,972.00	1.24	106.18	5,909.63	-481.27	-211.40	258.60	0.23
6,073.00	2.82	255.04	6,010.60	-482.22	-212.75	260.04	3.89

Design Report for Wells Ranch AA26-67-1HN - MWD Survey

Measured Depth (ft)	Inclination (°)	Azimuth (°)	Vertical Depth (ft)	+N/-S (ft)	+E/-W (ft)	Vertical Section (ft)	Dogleg Rate (°/100ft)
6,120.00	6.19	257.76	6,057.45	-483.06	-216.34	263.70	7.18
6,168.00	10.19	258.90	6,104.95	-484.42	-223.04	270.50	8.34
6,216.00	13.38	262.28	6,151.93	-485.99	-232.72	280.28	6.80
6,264.00	16.59	259.79	6,198.29	-487.95	-244.97	292.67	6.82
6,311.00	19.70	257.84	6,242.95	-490.81	-259.32	307.24	6.74
6,359.00	22.96	262.47	6,287.66	-493.74	-276.51	324.64	7.64
6,406.00	25.79	259.03	6,330.47	-496.89	-295.64	343.99	6.73
6,454.00	29.44	256.66	6,373.00	-501.60	-317.38	366.09	7.94
6,501.00	32.79	255.46	6,413.23	-507.46	-340.95	390.12	7.25
6,550.00	36.46	255.74	6,453.54	-514.38	-367.91	417.64	7.50
6,597.00	40.79	256.37	6,490.25	-521.44	-396.38	446.68	9.25
6,645.00	45.83	257.45	6,525.17	-528.88	-428.44	479.32	10.61
6,692.00	50.00	259.89	6,556.67	-535.71	-462.63	514.03	9.67
6,740.00	54.67	263.20	6,585.99	-541.25	-500.20	551.97	11.15
6,787.00	58.28	266.09	6,611.95	-544.89	-539.20	591.13	9.23
6,835.00	62.95	268.81	6,635.50	-546.73	-580.97	632.87	10.91
6,882.00	67.03	272.11	6,655.37	-546.36	-623.54	675.20	10.76
6,930.00	72.65	273.93	6,671.91	-543.98	-668.52	719.71	12.24
6,978.00	78.09	275.15	6,684.03	-540.30	-714.80	765.38	11.60
7,001.00	81.04	275.39	6,688.19	-538.22	-737.32	787.58	12.87
7,053.00	85.86	276.68	6,694.12	-532.79	-788.68	838.14	9.59
7,148.00	93.21	274.87	6,694.89	-523.24	-883.12	931.15	7.97
7,211.00	92.71	274.57	6,691.64	-518.06	-945.82	993.01	0.93
7,307.00	90.93	274.76	6,688.59	-510.26	-1,041.45	1,087.38	1.86
7,402.00	89.54	275.18	6,688.20	-502.03	-1,136.09	1,180.72	1.53
7,497.00	90.43	275.46	6,688.23	-493.22	-1,230.68	1,273.95	0.98
7,592.00	90.31	273.65	6,687.61	-485.67	-1,325.38	1,367.41	1.91
7,687.00	89.72	271.16	6,687.59	-481.69	-1,420.29	1,461.44	2.69
7,783.00	88.92	266.00	6,688.73	-484.07	-1,516.22	1,557.12	5.44
7,878.00	90.00	263.58	6,689.62	-492.69	-1,610.81	1,652.10	2.79
7,973.00	93.36	266.18	6,686.84	-501.17	-1,705.37	1,747.04	4.47
8,068.00	91.23	267.88	6,683.04	-506.08	-1,800.16	1,841.84	2.87
8,163.00	89.57	267.55	6,682.37	-509.87	-1,895.08	1,936.66	1.78
8,259.00	87.99	268.76	6,684.42	-512.96	-1,991.00	2,032.41	2.07
8,354.00	88.43	272.87	6,687.38	-511.61	-2,085.92	2,126.72	4.35
8,449.00	89.57	271.85	6,689.04	-507.70	-2,180.83	2,220.75	1.61
8,544.00	90.65	273.30	6,688.86	-503.43	-2,275.73	2,314.74	1.90
8,640.00	90.93	273.28	6,687.54	-497.92	-2,371.56	2,409.54	0.29
8,735.00	90.31	272.79	6,686.51	-492.89	-2,466.42	2,503.42	0.83
8,830.00	92.07	271.59	6,684.54	-489.26	-2,561.32	2,597.48	2.24
8,925.00	90.77	273.43	6,682.18	-485.10	-2,656.20	2,691.46	2.37
9,020.00	91.79	272.37	6,680.06	-480.30	-2,751.05	2,785.35	1.55
9,116.00	90.06	270.85	6,678.51	-477.60	-2,846.99	2,880.54	2.40
9,211.00	88.89	270.26	6,679.38	-476.68	-2,941.98	2,974.96	1.38
9,306.00	86.96	269.81	6,682.82	-476.62	-3,036.91	3,069.40	2.09
9,401.00	88.89	268.70	6,686.26	-477.86	-3,131.84	3,163.97	2.34
9,497.00	91.20	268.84	6,686.18	-479.92	-3,227.81	3,259.67	2.41
9,592.00	91.84	270.06	6,683.66	-480.83	-3,322.77	3,354.24	1.45
9,687.00	91.14	269.13	6,681.19	-481.50	-3,417.73	3,448.79	1.22
9,782.00	88.83	269.06	6,681.22	-483.00	-3,512.71	3,543.45	2.43
9,878.00	88.58	268.27	6,683.39	-485.24	-3,608.66	3,639.13	0.86

Design Report for Wells Ranch AA26-67-1HN - MWD Survey

Measured Depth (ft)	Inclination (°)	Azimuth (°)	Vertical Depth (ft)	+N/-S (ft)	+E/-W (ft)	Vertical Section (ft)	Dogleg Rate (°/100ft)
9,973.00	89.32	266.99	6,685.13	-489.17	-3,703.56	3,733.95	1.56
10,068.00	92.29	269.31	6,683.79	-492.23	-3,798.49	3,828.70	3.97
10,163.00	92.69	270.37	6,679.67	-492.50	-3,893.40	3,923.16	1.19
10,259.00	93.03	270.89	6,674.88	-491.44	-3,989.27	4,018.44	0.65
10,354.00	92.04	271.97	6,670.68	-489.08	-4,084.14	4,112.60	1.54
10,449.00	89.97	271.81	6,669.01	-485.94	-4,179.07	4,206.74	2.19
10,544.00	90.96	272.19	6,668.24	-482.63	-4,274.01	4,300.87	1.12
10,643.00	90.65	271.34	6,666.85	-479.58	-4,372.95	4,399.00	0.91
10,706.00	88.74	270.97	6,667.18	-478.31	-4,435.94	4,461.54	3.09
10,801.00	88.30	269.27	6,669.64	-478.11	-4,530.90	4,556.01	1.85
10,896.00	91.14	269.17	6,670.10	-479.40	-4,625.88	4,650.64	2.99
10,992.00	91.33	269.26	6,668.03	-480.72	-4,721.85	4,746.25	0.22
11,110.00	90.00	268.88	6,666.66	-482.63	-4,839.82	4,863.83	1.17
Final MWD Survey							
11,171.00	90.00	268.88	6,666.66	-483.83	-4,900.81	4,924.63	0.00
Survey Projection to TD - Estimated BHL: 1540' FNL, 537' FWL							

Design Annotations

Measured Depth (ft)	Vertical Depth (ft)	Local Coordinates		Comment
		+N/-S (ft)	+E/-W (ft)	
578.00	578.00	0.00	0.00	Surface Casing Assumed Vertical at 578.00ft
617.00	617.00	0.20	-0.27	First MWD Survey
11,110.00	6,666.66	-482.63	-4,839.82	Final MWD Survey
11,171.00	6,666.66	-483.83	-4,900.81	Survey Projection to TD
11,171.00	6,666.66	-483.83	-4,900.81	Estimated BHL: 1540' FNL, 537' FWL

Vertical Section Information

Angle Type	Target	Azimuth (°)	Origin Type	+N/-S (ft)	+E/-W (ft)	Start TVD (ft)
Target	Wells Ranch AA26-67-1HN_PlanA - Rev1_B HL Tgt	264.24	Slot	0.00	0.00	0.00

Survey tool program

From (ft)	To (ft)	Survey/Plan	Survey Tool
578.00	11,171.00	Sperry MWD Surveys	MWD

Design Report for Wells Ranch AA26-67-1HN - MWD Survey

Targets

Target Name - hit/miss target - Shape	Dip Angle (°)	Dip Dir. (°)	TVD (ft)	+N/-S (ft)	+E/-W (ft)	Northing (ft)	Easting (ft)	Latitude	Longitude
Wells Ranch	0.00	0.00	6,670.39	-494.23	-4,902.93	1,412,480.59	3,302,818.89	40° 27' 38.016 N	104° 24' 42.192 W
- actual wellpath misses target center by 11.25ft at 11171.00ft MD (6666.66 TVD, -483.83 N, -4900.81 E)									
- Point									
Wells Ranch	0.00	0.00	0.00	72.86	-0.91	1,413,047.66	3,307,720.73	40° 27' 43.020 N	104° 23' 38.688 W
- actual wellpath misses target center by 72.86ft at 0.00ft MD (0.00 TVD, 0.00 N, 0.00 E)									
- Polygon									
Point 1				-157.91	1,087.86	1,414,062.62	3,307,563.74		
Point 2				-111.91	-4,228.14	1,408,746.81	3,307,609.74		
Point 3				-5,407.91	-4,260.14	1,408,714.81	3,302,313.93		
Point 4				-5,447.91	1,050.86	1,414,025.62	3,302,273.93		
Point 5				-157.91	1,087.86	1,414,062.62	3,307,563.74		
Wells Ranch USX	0.00	0.00	4.00	89.34	151.94	1,413,064.14	3,307,873.58	40° 27' 43.164 N	104° 23' 36.708 W
- actual wellpath misses target center by 176.26ft at 4.00ft MD (4.00 TVD, 0.00 N, 0.00 E)									
- Polygon									
Point 1				-158.06	1,087.34	1,414,062.10	3,307,563.59		
Point 2				5,133.94	1,143.34	1,414,118.10	3,312,855.40		
Point 3				5,161.94	-4,161.66	1,408,813.29	3,312,883.40		
Point 4				-111.06	-4,227.66	1,408,747.29	3,307,610.59		
Point 5				-158.06	1,087.34	1,414,062.10	3,307,563.59		
Wells Ranch USX	0.00	0.00	4.00	89.34	151.94	1,413,064.14	3,307,873.58	40° 27' 43.164 N	104° 23' 36.708 W
- actual wellpath misses target center by 176.26ft at 4.00ft MD (4.00 TVD, 0.00 N, 0.00 E)									
- Polygon									
Point 1				301.94	627.34	1,413,602.12	3,308,023.57		
Point 2				4,673.94	683.34	1,413,658.11	3,312,395.41		
Point 3				4,701.94	-3,701.66	1,409,273.27	3,312,423.41		
Point 4				348.94	-3,767.66	1,409,207.28	3,308,070.57		
Point 5				301.94	627.34	1,413,602.12	3,308,023.57		
Wells Ranch	0.00	0.00	0.00	72.86	-0.91	1,413,047.66	3,307,720.73	40° 27' 43.020 N	104° 23' 38.688 W
- actual wellpath misses target center by 72.86ft at 0.00ft MD (0.00 TVD, 0.00 N, 0.00 E)									
- Polygon									
Point 1				-617.91	627.86	1,413,602.64	3,307,103.75		
Point 2				-571.91	-3,768.14	1,409,206.80	3,307,149.75		
Point 3				-4,947.91	-3,800.14	1,409,174.80	3,302,773.91		
Point 4				-4,987.91	590.86	1,413,565.64	3,302,733.91		
Point 5				-617.91	627.86	1,413,602.64	3,307,103.75		

North Reference Sheet for Sec. 25-T6N-R63W (Wells Ranch 26 PAD) - Wells Ranch AA26-67-1HN

All data is in US Feet unless otherwise stated. Directions and Coordinates are relative to Grid North Reference.

Vertical Depths are relative to KB @ 4843.00ft (H&P 315). Northing and Easting are relative to Wells Ranch AA26-67-1HN - Slot A3

Coordinate System is US State Plane 1983, Colorado Northern Zone using datum North American Datum 1983, ellipsoid GRS 1980

Projection method is Lambert Conformal Conic (2 parallel)

Central Meridian is 105° 30' 0.000 W°, Longitude Origin: 0° 0' 0.000 E°, Latitude Origin: 40° 47' 0.000 N°

False Easting: 3,000,000.00ft, False Northing: 1,000,000.00ft, Scale Reduction: 0.99996361


Grid Coordinates of Well: 1,412,974.80 ft N, 3,307,721.64 ft E


Geographical Coordinates of Well: 40° 27' 42.30" N, 104° 23' 38.69" W

Grid Convergence at Surface is: 0.71°

Based upon Minimum Curvature type calculations, at a Measured Depth of 11,171.00ft the Bottom Hole Displacement is 4,924.64ft in the Direction of 264.36° (Grid).

Magnetic Convergence at surface is: -7.83° (6 April 2012, , BGGM2011)

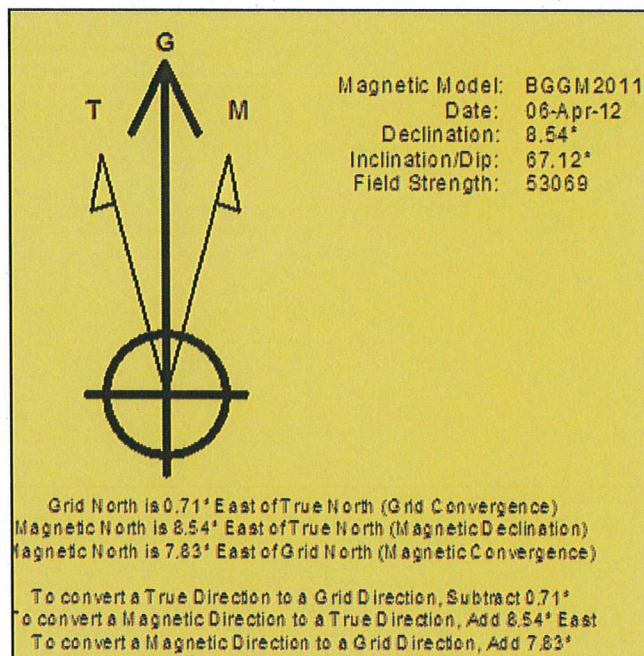


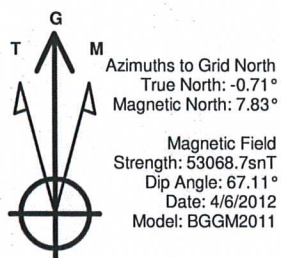

LEGEND


- Wells Ranch AA26-67-1HN, Plan A, Plan A - Rev 1 Proposal V
- MWD Survey

Halliburton Energy Services, Inc. ("Halliburton") recently completed directional drilling and MWD operations at the Wells Ranch AA26-67-1HN well located at Weld County, CO. At the conclusion of the job Halliburton performed a final survey on the well. Noble Energy has requested that Halliburton provide them the distances from BHL to section lines from that final survey to allow Noble Energy to meet its requirements under Colorado law. These distances are generated by a mathematical algorithm based on rough data collected after the well is drilled. Halliburton considers it to be a rough estimate only and it is not to be relied upon in any application where accurate data is required. In consideration for Halliburton releasing this data to Noble Energy, Noble Energy agrees to release Halliburton from any consequences of it or anyone else relying on such data.

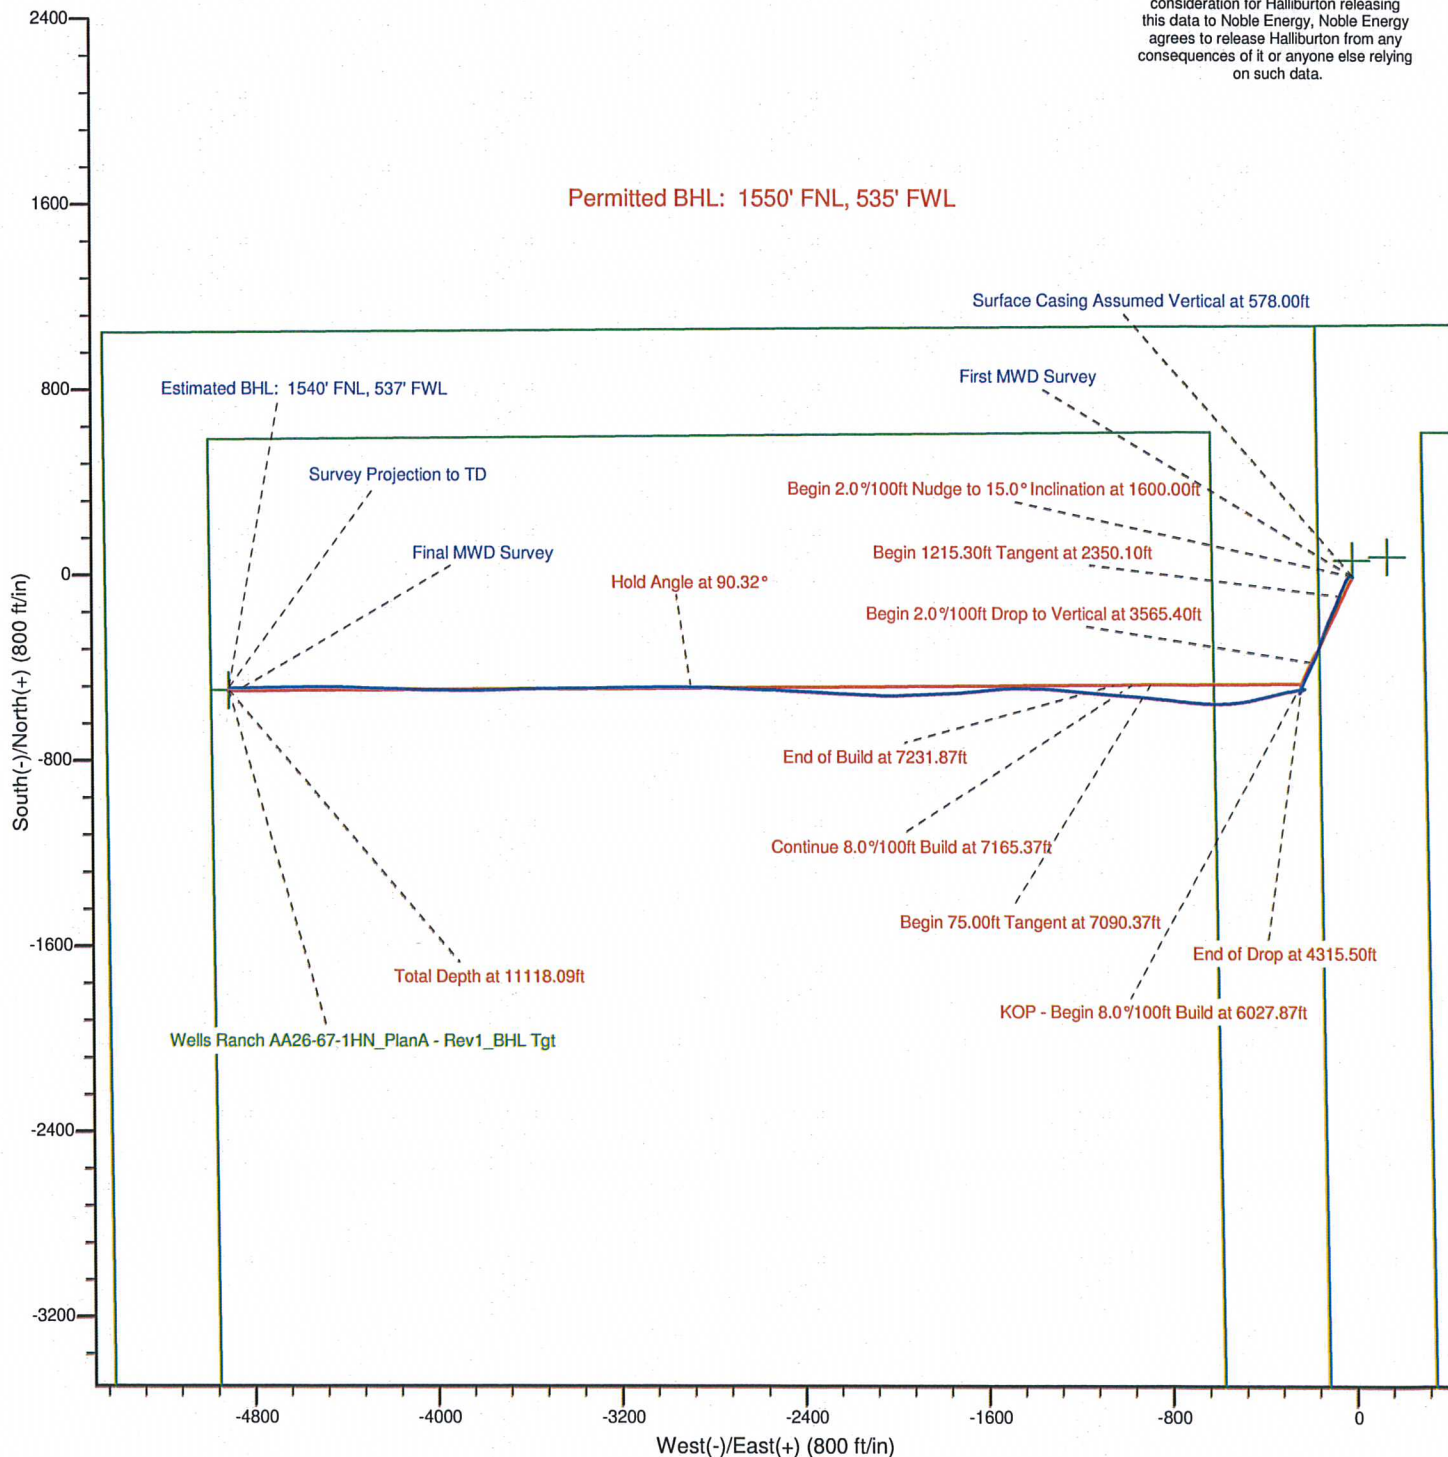

Project: Weld County, CO (NAD 83)
Site: Sec. 25-T6N-R63W (Wells Ranch 26 PAD)
Well: Wells Ranch AA26-67-1HN

Noble Energy

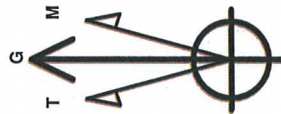

Azimuths to Grid North
True North: -0.71°
Magnetic North: 7.83°
Magnetic Field
Strength: 53068.7snT
Dip Angle: 67.11°
Date: 4/6/2012
Model: BGGM2011

LEGEND

- Wells Ranch AA26-67-1HN, Plan A, Plan A - Rev 1 Proposal V0
- MWD Survey

Halliburton Energy Services, Inc. ("Halliburton") recently completed directional drilling and MWD operations at the Wells Ranch AA26-67-1HN well located at Weld County, CO. At the conclusion of the job Halliburton performed a final survey on the well. Noble Energy has requested that Halliburton provide them the distances from BHL to section lines from that final survey to allow Noble Energy to meet its requirements under Colorado law. These distances are generated by a mathematical algorithm based on rough data collected after the well is drilled. Halliburton considers it to be a rough estimate only and it is not to be relied upon in any application where accurate data is required. In consideration for Halliburton releasing this data to Noble Energy, Noble Energy agrees to release Halliburton from any consequences of it or anyone else relying on such data.

