




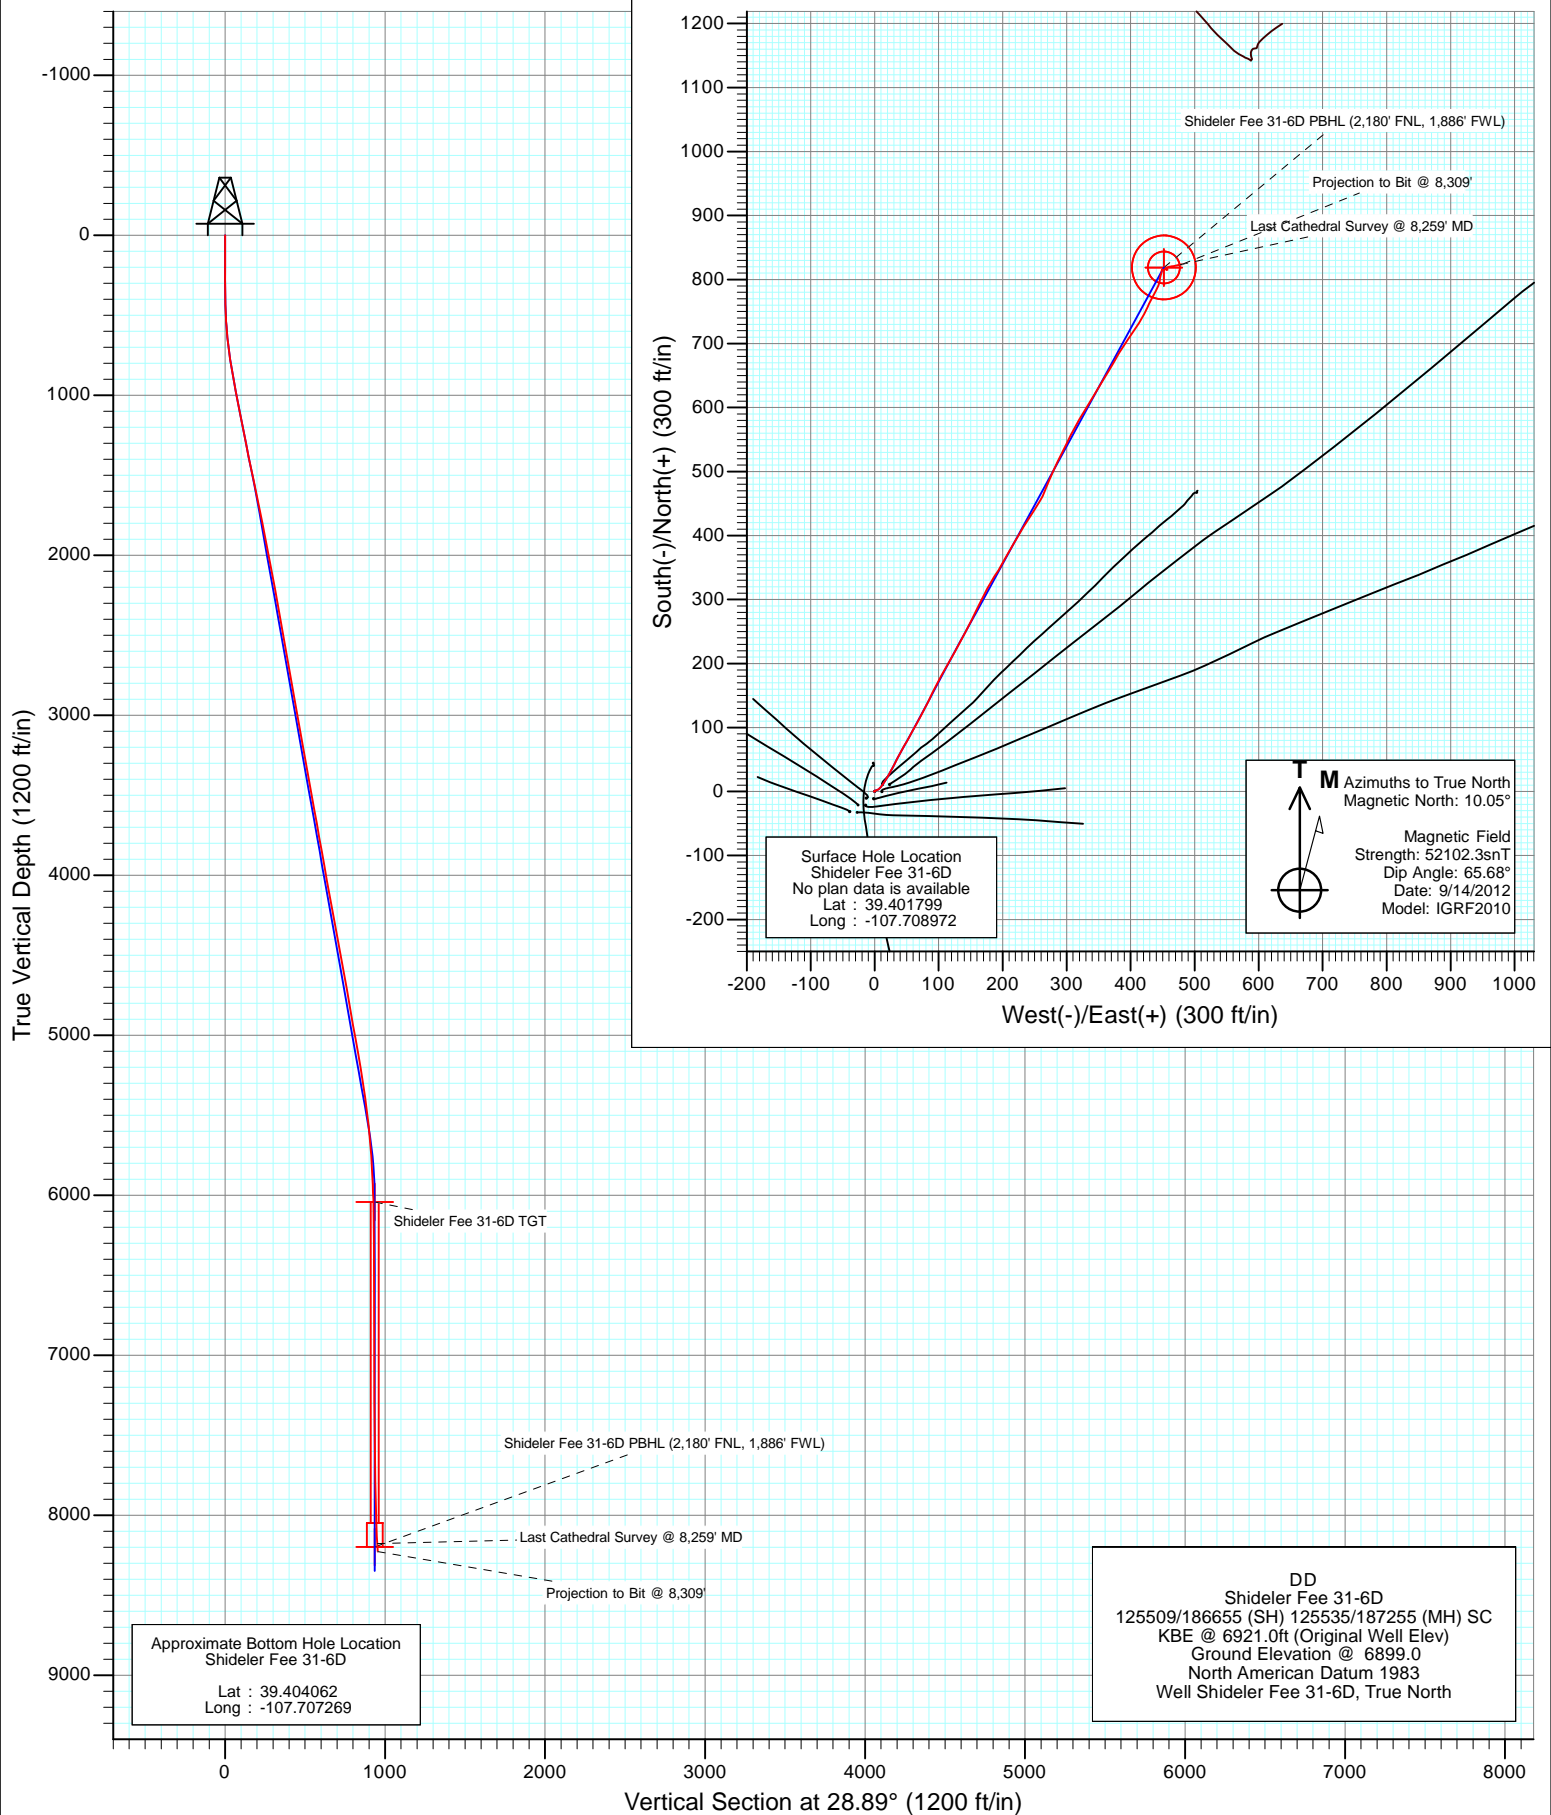

Project: Mamm Creek
Site: K31E Pad
Well: Shideler Fee 31-6D
Wellbore: DD
Design: FINAL

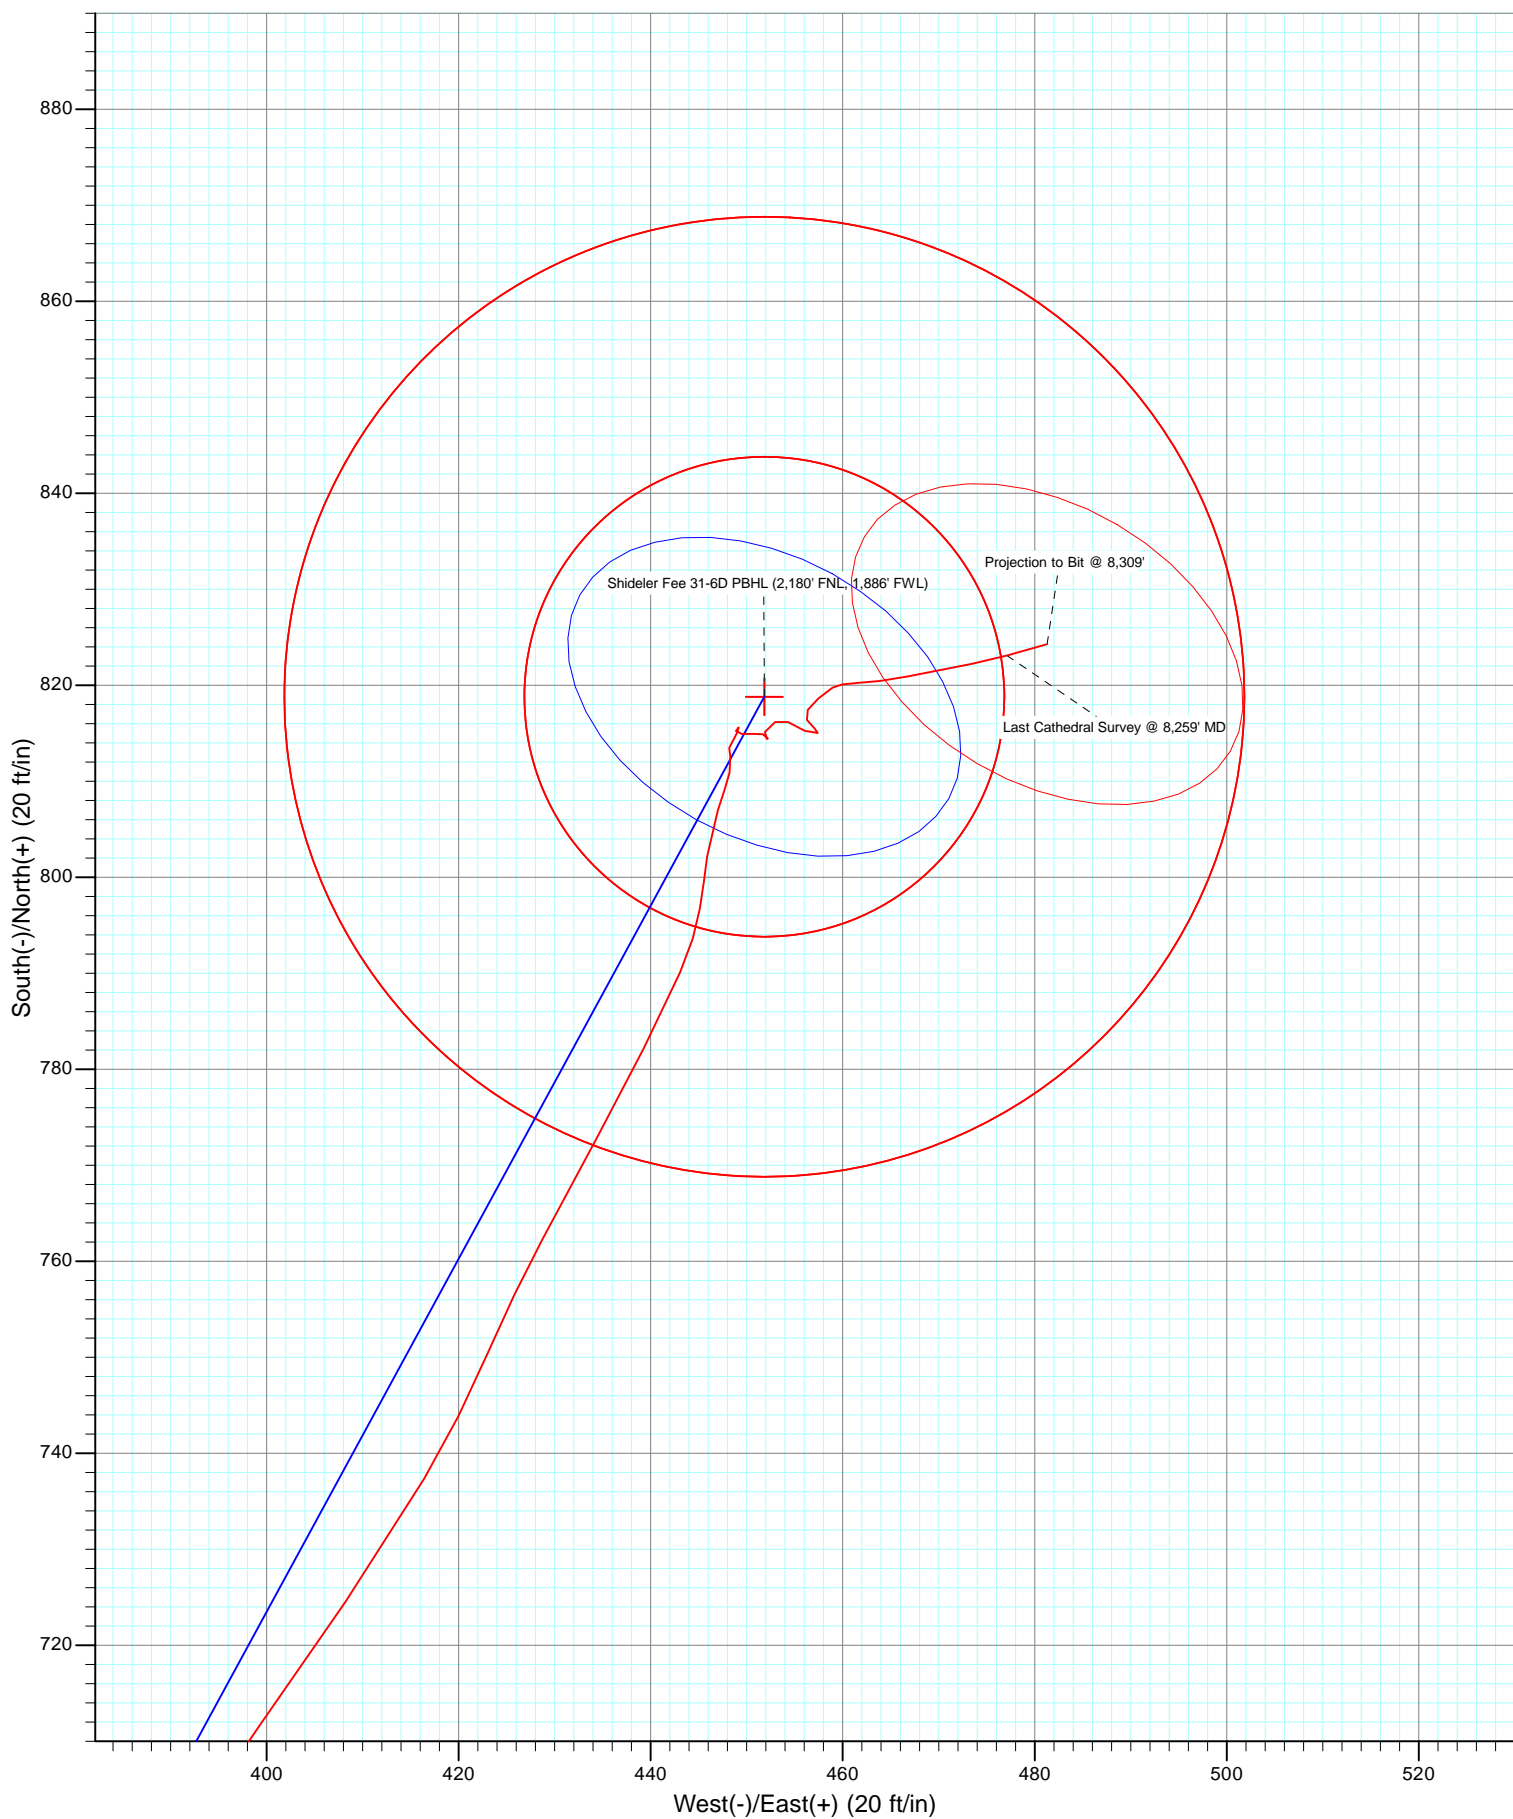

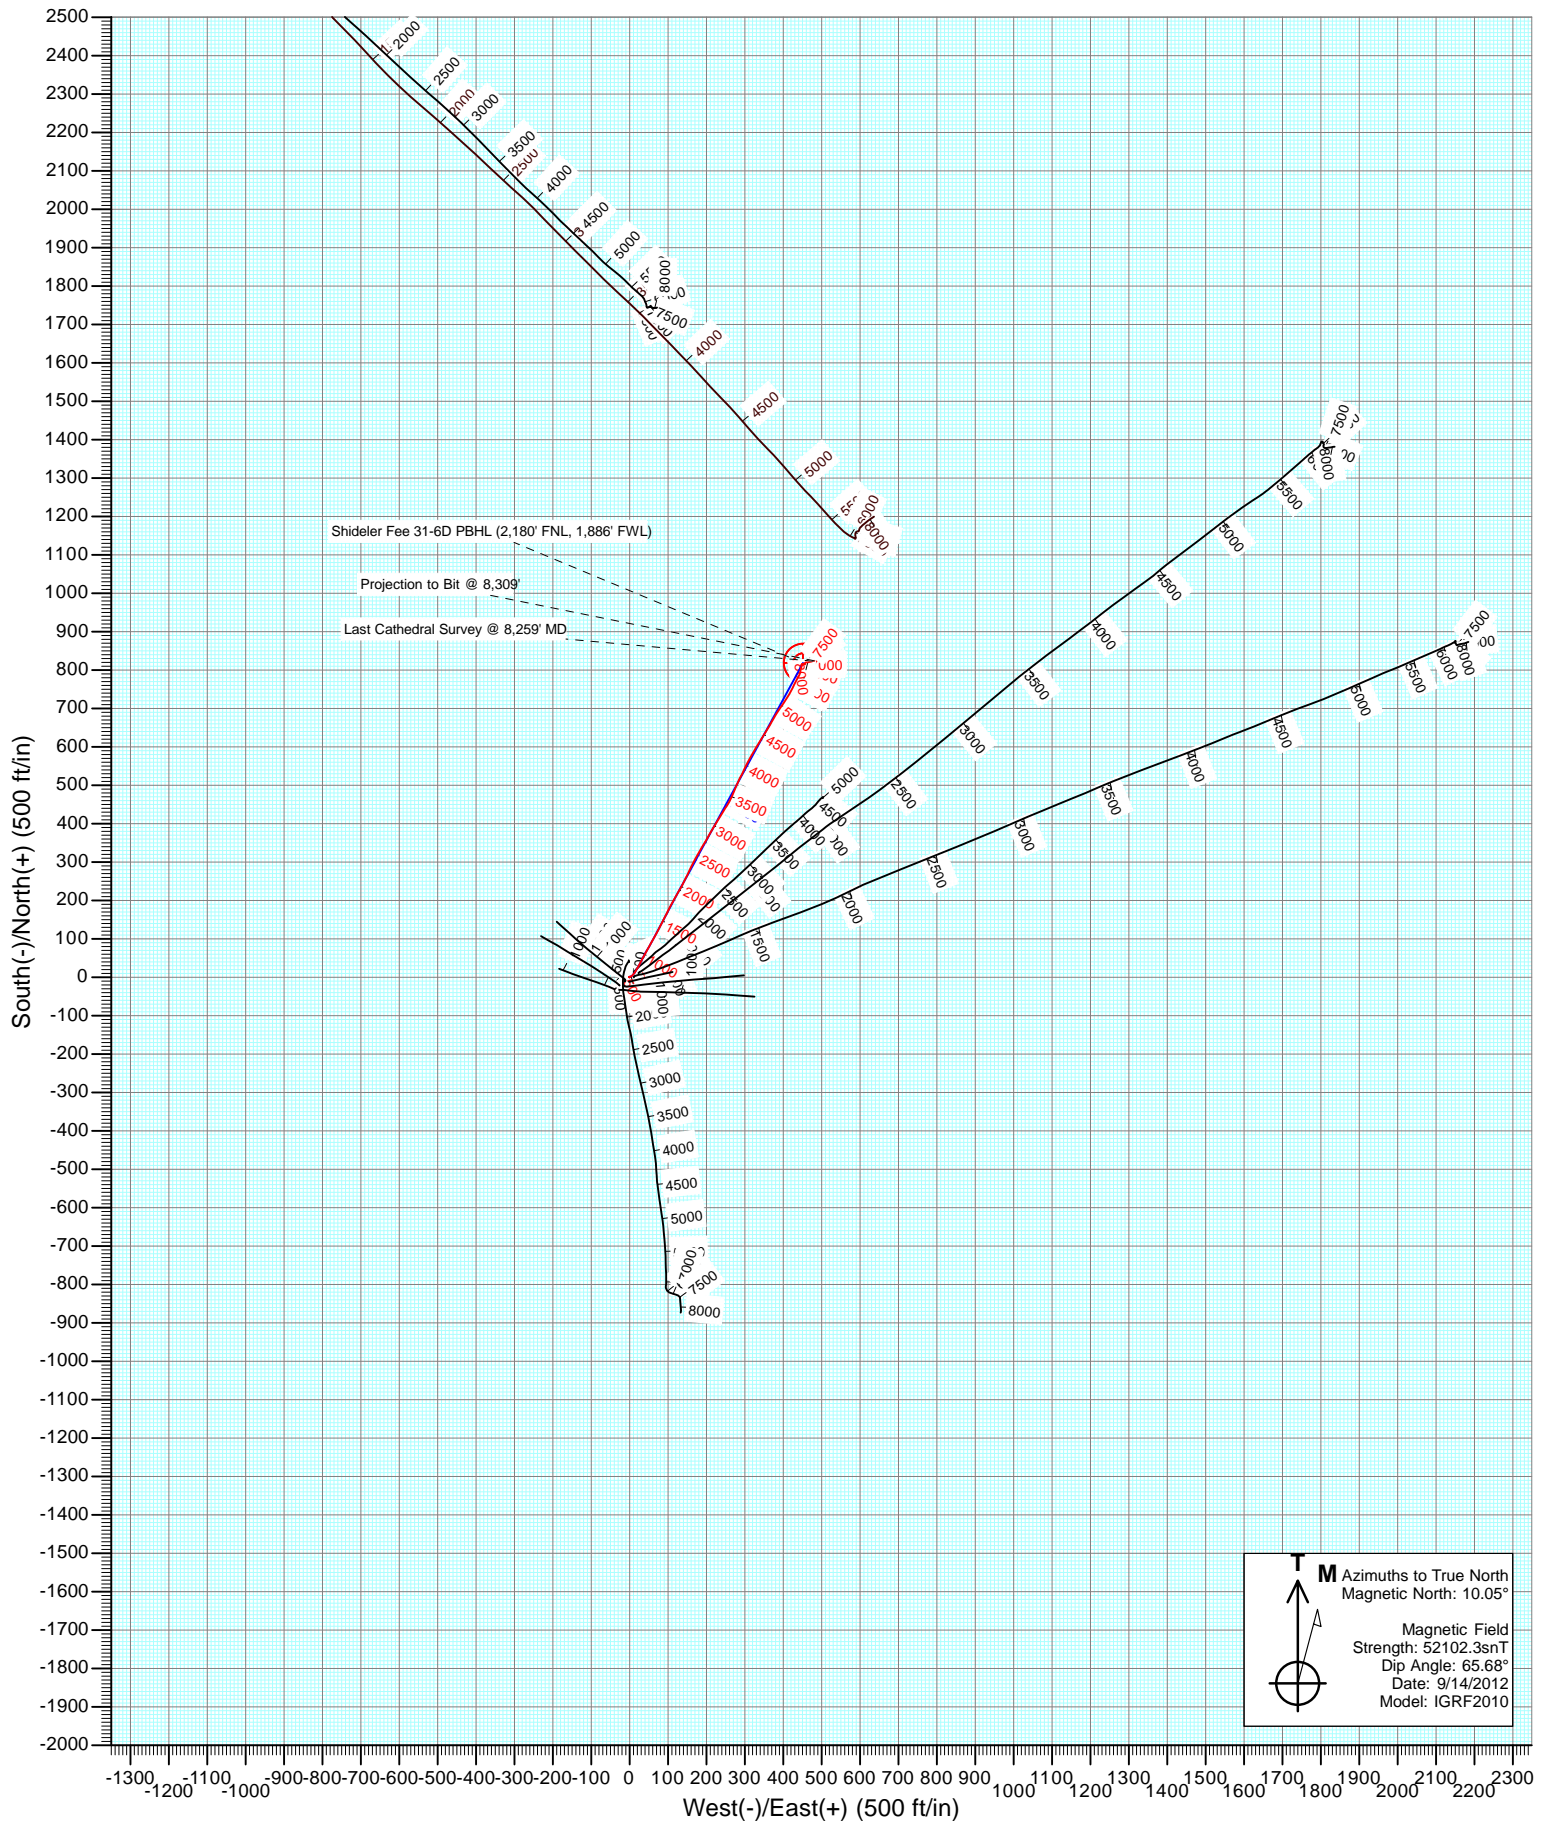



Cathedral Energy Services

Survey Report

Company:	EnCana Oil & Gas (USA) Inc	Local Co-ordinate Reference:	Well Shideler Fee 31-6D
Project:	Mamm Creek	TVD Reference:	KBE @ 6921.0ft (Original Well Elev)
Site:	K31E Pad	MD Reference:	KBE @ 6921.0ft (Original Well Elev)
Well:	Shideler Fee 31-6D	North Reference:	True
Wellbore:	DD	Survey Calculation Method:	Minimum Curvature
Design:	DD	Database:	USA EDM 5000 Multi Users DB

Project	Mamm Creek		
Map System:	US State Plane 1983	System Datum:	Mean Sea Level
Geo Datum:	North American Datum 1983		
Map Zone:	Colorado Central Zone		

Site		K31E Pad			
Site Position:		Northing:	1,578,791.89 ft	Latitude:	39.401699
From:	Lat/Long	Easting:	2,375,816.61 ft	Longitude:	-107.709119
Position Uncertainty:	0.0 ft	Slot Radius:	13.200 in	Grid Convergence:	-1.39 °

Well		Shideler Fee 31-6D				
Well Position	+N/-S	0.0 ft	Northing:	1,578,827.28 ft	Latitude:	39.401799
	+E/-W	0.0 ft	Easting:	2,375,859.02 ft	Longitude:	-107.708972
Position Uncertainty		0.0 ft	Wellhead Elevation:	ft	Ground Level:	6,899.0 ft

Wellbore	DD				
Magnetics	Model Name	Sample Date	Declination (°)	Dip Angle (°)	Field Strength (nT)
	IGRF2010	9/14/2012	10.05	65.68	52,102

Design	DD			
Audit Notes:				
Version:	1.0	Phase:	ACTUAL	Tie On Depth: 0.0
Vertical Section:	Depth From (TVD)	+N/-S	+E/-W	Direction
	(ft)	(ft)	(ft)	(°)
	0.0	0.0	0.0	28.89

Survey Program	Date	9/23/2012			
From (ft)	To (ft)	Survey (Wellbore)	Tool Name	Description	
110.0	8,309.0	Survey #1 (DD)	MWD	Geolink MWD	

Survey										
Measured Depth (ft)	Inclination (°)	Azimuth (°)	Vertical Depth (ft)	+N/-S (ft)	+E/-W (ft)	Vertical Section (ft)	Dogleg Rate (°/100ft)	Build Rate (°/100ft)	Formations / Comments	
0.0	0.00	0.00	0.0	0.0	0.0	0.0	0.00	0.00		
110.0	0.40	271.40	110.0	0.0	-0.4	-0.2	0.36	0.36		
141.0	0.20	280.10	141.0	0.0	-0.5	-0.2	0.66	-0.65		
171.0	0.10	48.30	171.0	0.0	-0.6	-0.2	0.91	-0.33		
202.0	0.10	60.90	202.0	0.1	-0.5	-0.2	0.07	0.00		
232.0	0.40	18.20	232.0	0.2	-0.5	-0.1	1.11	1.00		
263.0	0.20	339.00	263.0	0.3	-0.5	0.1	0.89	-0.65		
294.0	0.50	3.50	294.0	0.5	-0.5	0.2	1.06	0.97		
325.0	0.60	17.40	325.0	0.8	-0.4	0.5	0.54	0.32		
356.0	0.40	33.10	356.0	1.1	-0.3	0.8	0.78	-0.65		
386.0	1.10	72.10	386.0	1.2	0.0	1.1	2.76	2.33		
417.0	1.60	74.70	417.0	1.4	0.7	1.6	1.62	1.61		
448.0	2.20	78.20	448.0	1.7	1.7	2.3	1.97	1.94		

Cathedral Energy Services

Survey Report

Company:	EnCana Oil & Gas (USA) Inc	Local Co-ordinate Reference:	Well Shideler Fee 31-6D
Project:	Mamm Creek	TVD Reference:	KBE @ 6921.0ft (Original Well Elev)
Site:	K31E Pad	MD Reference:	KBE @ 6921.0ft (Original Well Elev)
Well:	Shideler Fee 31-6D	North Reference:	True
Wellbore:	DD	Survey Calculation Method:	Minimum Curvature
Design:	DD	Database:	USA EDM 5000 Multi Users DB

Survey									
Measured Depth (ft)	Inclination (°)	Azimuth (°)	Vertical Depth (ft)	+N/-S (ft)	+E/-W (ft)	Vertical Section (ft)	Dogleg Rate (°/100ft)	Build Rate (°/100ft)	Formations / Comments
479.0	2.80	71.60	478.9	2.0	3.0	3.3	2.14	1.94	
509.0	3.40	60.20	508.9	2.7	4.5	4.5	2.86	2.00	
540.0	3.80	52.60	539.8	3.8	6.1	6.3	2.01	1.29	
570.0	4.30	46.00	569.8	5.2	7.7	8.3	2.28	1.67	
601.0	5.10	40.50	600.7	7.0	9.4	10.7	2.96	2.58	
632.0	5.60	36.70	631.5	9.3	11.2	13.6	1.98	1.61	
663.0	6.50	35.10	662.3	11.9	13.1	16.8	2.95	2.90	
755.0	8.10	30.60	753.6	21.8	19.4	28.5	1.85	1.74	
847.0	9.80	28.30	844.5	34.3	26.5	42.8	1.89	1.85	
939.0	10.90	26.00	935.0	49.0	34.0	59.3	1.28	1.20	
1,031.0	10.50	29.70	1,025.4	64.1	41.9	76.4	0.86	-0.43	
1,124.0	11.10	30.00	1,116.7	79.2	50.6	93.8	0.65	0.65	
1,216.0	11.40	29.00	1,207.0	94.8	59.5	111.7	0.39	0.33	
1,308.0	10.90	28.00	1,297.2	110.4	67.9	129.5	0.58	-0.54	
1,400.0	11.10	27.70	1,387.5	126.0	76.1	147.1	0.23	0.22	
1,492.0	11.80	27.10	1,477.7	142.2	84.5	165.3	0.77	0.76	
1,620.0	12.10	26.80	1,602.9	165.8	96.6	191.8	0.24	0.23	
1,711.0	12.50	26.60	1,691.8	183.1	105.3	211.2	0.44	0.44	
1,803.0	11.20	30.70	1,781.9	199.7	114.3	230.1	1.68	-1.41	
1,895.0	11.20	31.20	1,872.1	215.0	123.5	247.9	0.11	0.00	
1,986.0	10.30	26.90	1,961.5	229.8	131.7	264.9	1.32	-0.99	
2,078.0	10.60	27.20	2,052.0	244.7	139.3	281.6	0.33	0.33	
2,169.0	11.20	28.10	2,141.4	260.0	147.3	298.8	0.69	0.66	
2,260.0	10.20	25.00	2,230.8	275.0	154.9	315.6	1.27	-1.10	
2,352.0	10.80	26.00	2,321.2	290.2	162.1	332.4	0.68	0.65	
2,443.0	9.80	27.70	2,410.8	304.7	169.4	348.6	1.15	-1.10	
2,535.0	10.10	27.50	2,501.4	318.8	176.8	364.5	0.33	0.33	
2,627.0	9.70	33.30	2,592.0	332.4	184.8	380.3	1.17	-0.43	
2,719.0	9.60	31.10	2,682.7	345.5	193.0	395.7	0.42	-0.11	
2,810.0	9.90	29.00	2,772.4	358.8	200.7	411.1	0.51	0.33	
2,902.0	10.50	29.30	2,862.9	373.0	208.7	427.4	0.65	0.65	
2,994.0	10.60	31.00	2,953.4	387.6	217.1	444.3	0.36	0.11	
3,085.0	9.50	30.80	3,043.0	401.2	225.3	460.1	1.21	-1.21	
3,177.0	9.50	31.00	3,133.7	414.3	233.1	475.3	0.04	0.00	
3,269.0	9.80	33.20	3,224.4	427.3	241.3	490.7	0.52	0.33	
3,360.0	10.20	33.30	3,314.1	440.5	249.9	506.5	0.44	0.44	
3,452.0	10.40	29.60	3,404.6	454.6	258.5	522.9	0.75	0.22	
3,543.0	10.50	21.70	3,494.1	469.4	265.6	539.3	1.58	0.11	
3,635.0	10.50	23.50	3,584.5	484.9	272.1	556.0	0.36	0.00	
3,726.0	10.50	23.70	3,674.0	500.1	278.7	572.5	0.04	0.00	
3,818.0	9.90	25.90	3,764.5	514.9	285.5	588.7	0.78	-0.65	
3,909.0	10.00	27.20	3,854.2	528.9	292.6	604.4	0.27	0.11	
4,001.0	10.10	25.30	3,944.8	543.3	299.7	620.5	0.38	0.11	
4,092.0	10.20	28.80	4,034.3	557.6	307.0	636.5	0.69	0.11	
4,184.0	11.00	27.10	4,124.8	572.6	314.9	653.4	0.93	0.87	
4,276.0	9.90	30.80	4,215.2	587.2	322.9	670.1	1.40	-1.20	
4,367.0	10.30	31.00	4,304.8	600.9	331.1	686.1	0.44	0.44	
4,459.0	10.80	33.30	4,395.3	615.1	340.1	702.9	0.71	0.54	
4,550.0	10.20	30.00	4,484.8	629.2	348.8	719.4	0.93	-0.66	
4,642.0	10.30	29.90	4,575.3	643.4	357.0	735.8	0.11	0.11	
4,733.0	10.50	33.40	4,664.8	657.4	365.6	752.2	0.73	0.22	
4,825.0	10.00	28.00	4,755.3	671.4	374.0	768.5	1.18	-0.54	
4,917.0	9.80	31.60	4,846.0	685.1	381.8	784.3	0.71	-0.22	

Cathedral Energy Services

Survey Report

Company:	EnCana Oil & Gas (USA) Inc	Local Co-ordinate Reference:	Well Shideler Fee 31-6D
Project:	Mamm Creek	TVD Reference:	KBE @ 6921.0ft (Original Well Elev)
Site:	K31E Pad	MD Reference:	KBE @ 6921.0ft (Original Well Elev)
Well:	Shideler Fee 31-6D	North Reference:	True
Wellbore:	DD	Survey Calculation Method:	Minimum Curvature
Design:	DD	Database:	USA EDM 5000 Multi Users DB

Survey

Measured Depth (ft)	Inclination (°)	Azimuth (°)	Vertical Depth (ft)	+N/-S (ft)	+E/-W (ft)	Vertical Section (ft)	Dogleg Rate (°/100ft)	Build Rate (°/100ft)	Formations / Comments
5,008.0	9.90	33.30	4,935.6	698.3	390.2	799.9	0.34	0.11	
5,099.0	10.20	35.10	5,025.2	711.4	399.1	815.7	0.48	0.33	
5,191.0	9.80	34.60	5,115.8	724.5	408.2	831.6	0.44	-0.43	
5,282.0	9.50	30.30	5,205.5	737.4	416.4	846.8	0.86	-0.33	
5,374.0	8.70	23.20	5,296.4	750.3	423.0	861.3	1.50	-0.87	
5,465.0	8.00	28.30	5,386.4	762.2	428.7	874.5	1.12	-0.77	
5,557.0	7.20	28.00	5,477.6	773.0	434.4	886.7	0.87	-0.87	
5,648.0	5.90	27.30	5,568.0	782.2	439.3	897.0	1.43	-1.43	
5,740.0	5.10	23.50	5,659.6	790.1	443.1	905.8	0.95	-0.87	
5,831.0	3.70	8.60	5,750.3	796.7	445.1	912.6	1.97	-1.54	
5,877.0	3.50	7.90	5,796.2	799.6	445.5	915.3	0.45	-0.43	
5,923.0	3.00	7.20	5,842.2	802.2	445.9	917.7	1.09	-1.09	
6,015.0	3.20	18.80	5,934.0	807.0	447.0	922.5	0.71	0.22	
6,107.0	1.90	14.70	6,025.9	810.9	448.2	926.5	1.43	-1.41	
6,199.0	0.50	308.90	6,117.9	812.6	448.3	928.1	1.91	-1.52	
6,291.0	0.80	18.20	6,209.9	813.5	448.2	928.8	0.85	0.33	
6,382.0	1.30	32.90	6,300.9	814.9	448.9	930.4	0.62	0.55	
6,474.0	0.50	237.80	6,392.9	815.6	449.2	931.1	1.92	-0.87	
6,566.0	0.20	159.90	6,484.9	815.2	448.9	930.6	0.54	-0.33	
6,658.0	0.70	107.50	6,576.9	814.9	449.5	930.7	0.65	0.54	
6,749.0	1.00	77.30	6,667.9	814.9	450.8	931.3	0.58	0.33	
6,841.0	0.30	148.10	6,759.9	814.9	451.7	931.7	1.03	-0.76	
6,932.0	0.60	122.90	6,850.9	814.4	452.2	931.6	0.39	0.33	
7,023.0	0.70	294.90	6,941.9	814.4	452.1	931.5	1.43	0.11	
7,115.0	0.70	30.90	7,033.9	815.1	451.9	932.0	1.13	0.00	
7,206.0	1.20	54.80	7,124.8	816.2	452.9	933.4	0.69	0.55	
7,298.0	1.00	133.30	7,216.8	816.2	454.3	934.1	1.52	-0.22	
7,390.0	1.50	107.50	7,308.8	815.3	456.0	934.1	0.81	0.54	
7,481.0	0.30	58.10	7,399.8	815.0	457.4	934.6	1.46	-1.32	
7,573.0	0.80	304.80	7,491.8	815.5	457.1	934.8	1.04	0.54	
7,665.0	0.70	332.70	7,583.8	816.4	456.3	935.2	0.41	-0.11	
7,756.0	0.80	30.70	7,674.8	817.4	456.3	936.2	0.80	0.11	
7,847.0	1.30	49.80	7,765.8	818.6	457.5	937.8	0.66	0.55	
7,939.0	1.00	57.30	7,857.7	819.7	458.9	939.4	0.36	-0.33	
8,030.0	2.50	87.80	7,948.7	820.2	461.6	941.2	1.88	1.65	
8,122.0	4.10	79.30	8,040.5	820.9	466.8	944.3	1.81	1.74	
8,213.0	4.40	78.70	8,131.3	822.2	473.4	948.6	0.33	0.33	
8,259.0	5.00	74.30	8,177.1	823.1	477.1	951.2	1.52	1.30	Last Cathedral Survey @ 8,259' MD
8,309.0	5.00	74.30	8,227.0	824.3	481.3	954.2	0.00	0.00	Projection to Bit @ 8,309'

Cathedral Energy Services

Survey Report

Company:	EnCana Oil & Gas (USA) Inc	Local Co-ordinate Reference:	Well Shideler Fee 31-6D
Project:	Mamm Creek	TVD Reference:	KBE @ 6921.0ft (Original Well Elev)
Site:	K31E Pad	MD Reference:	KBE @ 6921.0ft (Original Well Elev)
Well:	Shideler Fee 31-6D	North Reference:	True
Wellbore:	DD	Survey Calculation Method:	Minimum Curvature
Design:	DD	Database:	USA EDM 5000 Multi Users DB

Targets									
Target Name	Dip Angle	Dip Dir.	TVD	+N/-S	+E/-W	Northing	Easting	Latitude	Longitude
- hit/miss target	(°)	(°)	(ft)	(ft)	(ft)	(ft)	(ft)		
- Shape									
Shideler Fee 31-6D PBI-	0.00	0.00	8,198.0	818.8	451.8	1,579,634.86	2,376,330.63	39.404047	-107.707373
- actual wellpath misses target center by 33.1ft at 8259.0ft MD (8177.1 TVD, 823.1 N, 477.1 E)									
- Circle (radius 50.0)									
Shideler Fee 31-6D TGT	0.00	0.00	6,042.0	818.8	451.8	1,579,634.86	2,376,330.63	39.404047	-107.707373
- actual wellpath misses target center by 8.2ft at 6123.2ft MD (6042.1 TVD, 811.4 N, 448.3 E)									
- Circle (radius 25.0)									

Design Annotations					
Measured Depth	Vertical Depth	Local Coordinates			
(ft)	(ft)	+N/-S	+E/-W		
		(ft)	(ft)	Comment	
8,259.0	8,177.1	823.1	477.1	Last Cathedral Survey @ 8,259' MD	
8,309.0	8,227.0	824.3	481.3	Projection to Bit @ 8,309'	

Checked By: _____ Approved By: _____ Date: _____