


KERR-MCGEE ROCKY MOUNTAIN CORP

UPRR 42 PAN AM 1
NW SW 29 3N 66W -- --
WELD,COLORADO
02/28/2013

AREA: N3 ROUTE: N31 Spud: 12/29/1970 WINS No.: 73892 AFE/WO#: 2080763 API#: 0512307231

GL: 4898 KB: 4907 MTD: 7972 TVD: 7972 LOG MD: PBMD: 7932 PBTVD: 7932

Directions: HWY 85 & WCR 28, E 4/10, N 3/10, E 1/10, N INTO

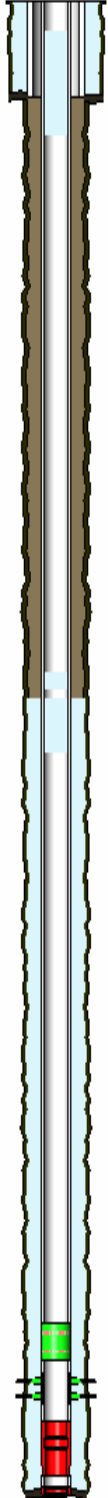

<u>HOLE SECTIONS</u>		<u>Size</u>	<u>Top</u>	<u>Btm</u>	<u>TD Date</u>			
SURFACE		12.25	9	570				
PRODUCTION		7.88	470	7972				
<u>TUBULARS</u>	<u>Tool Type</u>	<u>Joints</u>	<u>Size</u>	<u>Weight</u>	<u>Grade</u>	<u>Thread</u>	<u>Top D</u>	<u>Bottom D</u>
SURFACE CASING	Casing	19	8.63	24.00			9	567
PRODUCTION CASING	Casing	244	4.50	11.50			9	7932
	Float Collar	1	4.50				7932	7933
	Casing	1	4.50	11.50			7933	7971
	Casing Shoe	1	4.50				7971	7972
BRIDGE PLUG	Cast Iron Bridge Plu	1	4.50				7775	7777
<u>CEMENT JOBS</u>	<u>Stage</u>	<u>Sacks</u>	<u>Cement Jobs</u>			<u>Top D</u>	<u>Btm D</u>	<u>cbl</u>
SURFACE CASING	STAGE 1	500		REGULAR		9	568	No
SURFACE CASING	STAGE 1	200		LEAD		5000	7970	No
PRODUCTION CASING	ABANDONMENT PLUC	25	LEAD	NEAT		7770	7775	No
PRODUCTION CASING	SQUEEZE JOB	225	LEAD	PREMIUM		6650	7210	No
PRODUCTION CASING	SQUEEZE JOB	550	LEAD	PREMIUM		4100	5105	No
PRODUCTION CASING	ABANDONMENT PLUC	175	LEAD	NEAT		4100	4420	No
PRODUCTION CASING	ABANDONMENT PLUC	100	LEAD	NEAT		3950	4050	No
PRODUCTION CASING	ABANDONMENT PLUC					500	790	No
PRODUCTION CASING	ABANDONMENT PLUC	150	LEAD	NEAT		180	640	No
<u>PERFORATIONS</u>								
<u>Formation</u>	<u>Zone</u>	<u>Top</u>	<u>Btm</u>	<u>Date</u>	<u>Reason</u>	<u>Comments</u>		
SUSSEX		4050	4051	01/30/2013	CEMENT SQUEEZE			
SUSSEX		4100	4101	01/26/2013	CEMENT SQUEEZE			
SUSSEX		4420	4421	01/29/2013	CEMENT SQUEEZE			
SHANNON /BENTOI		5105	5106	01/26/2013	CEMENT SQUEEZE			
NIORARA		7210	7211	01/25/2013	CEMENT SQUEEZE			
J SAND		7846	7872	01/30/1973	PRODUCTION			
J SAND		7855	7855	01/19/1971	PRODUCTION			

Comments: