

## Well


Operator  
Location  
County  
State  
Field  
Footages  
API No.  
P&A Date:

## CANYON CREEK 8-6-13

EnCana Oil & Gas (USA) Inc.  
NWSE Section 13-T1N-R69W  
BOULDER  
Colorado  
Wattenberg  
2041' FSL & 2124' FEL  
05-013-06628-00  
07-04-12



### Canyon Creek 8-6-13 P&A Borehole Diagram

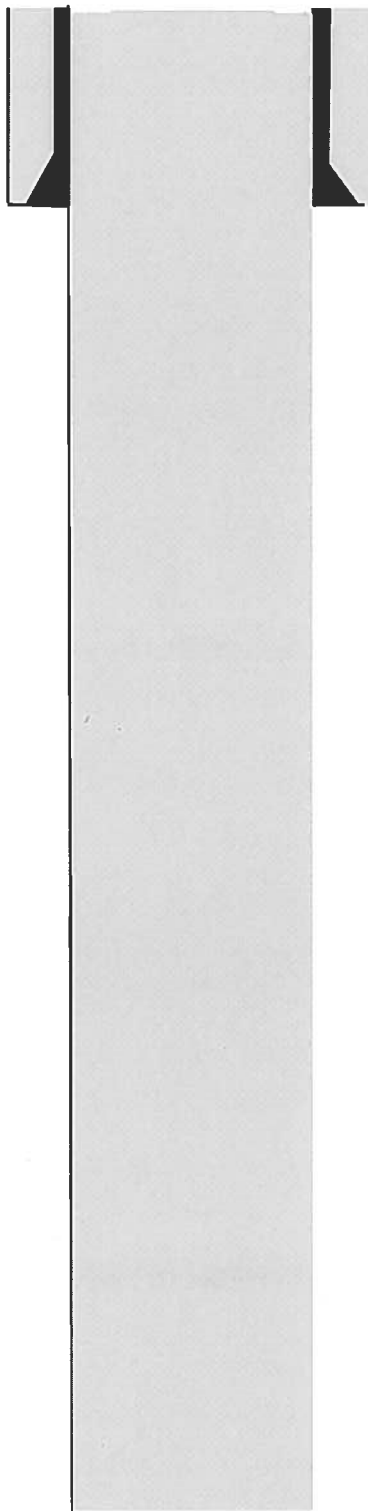

26" conductor hole  
drilled to 187'

16", 57.5 ppf conductor  
pipe cemented from 187'  
to surface with 20 yds.  
cement

12-1/4" surface hole drilled  
to 380' MD – hole was  
abandoned by cementing  
from 386' to surface with  
440 sxs.