



# Saulcy 3 Post PA

05-069-06112 Diagram

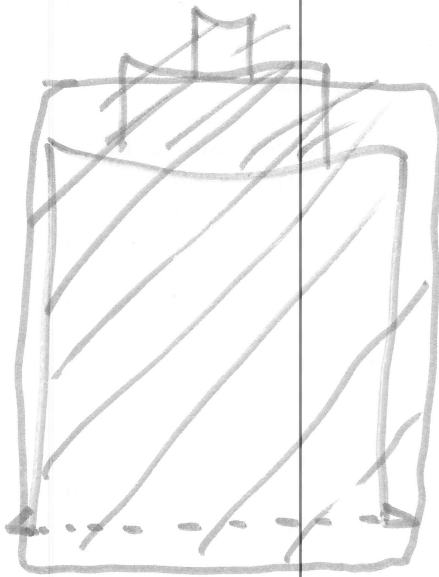

180 sx from  
275' to surf

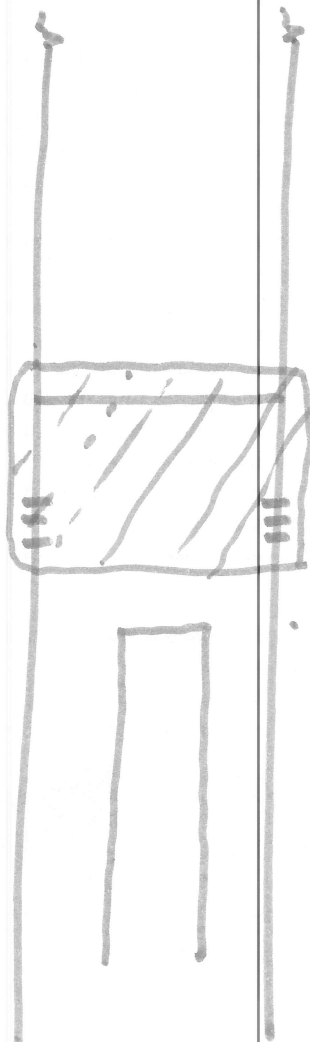

2635' casing cut

5 sx on top  
Retainer @ 3200'  
60 sx plug  
squeeze holes @ 3300'

3517 tubing cut

4 1/2 to 4770'