


Current Wellbore Schematic

EnCana Oil & Gas (USA) Inc.



WELL : Stelling 3A-4H – Cemented Perf/Plug
LOCATION : Lat: 40.075200 Long: -104.671220
COUNTY : WELD **STATE**: CO
FIELD : Wattenburg - NIOBRARA
ELEVATION : 4917' (GL) 4930' (KB) Δ 13'

SPUD DATE: 6/07/12
COMPL. DATE: 8/8/12
API #: 05123347640000

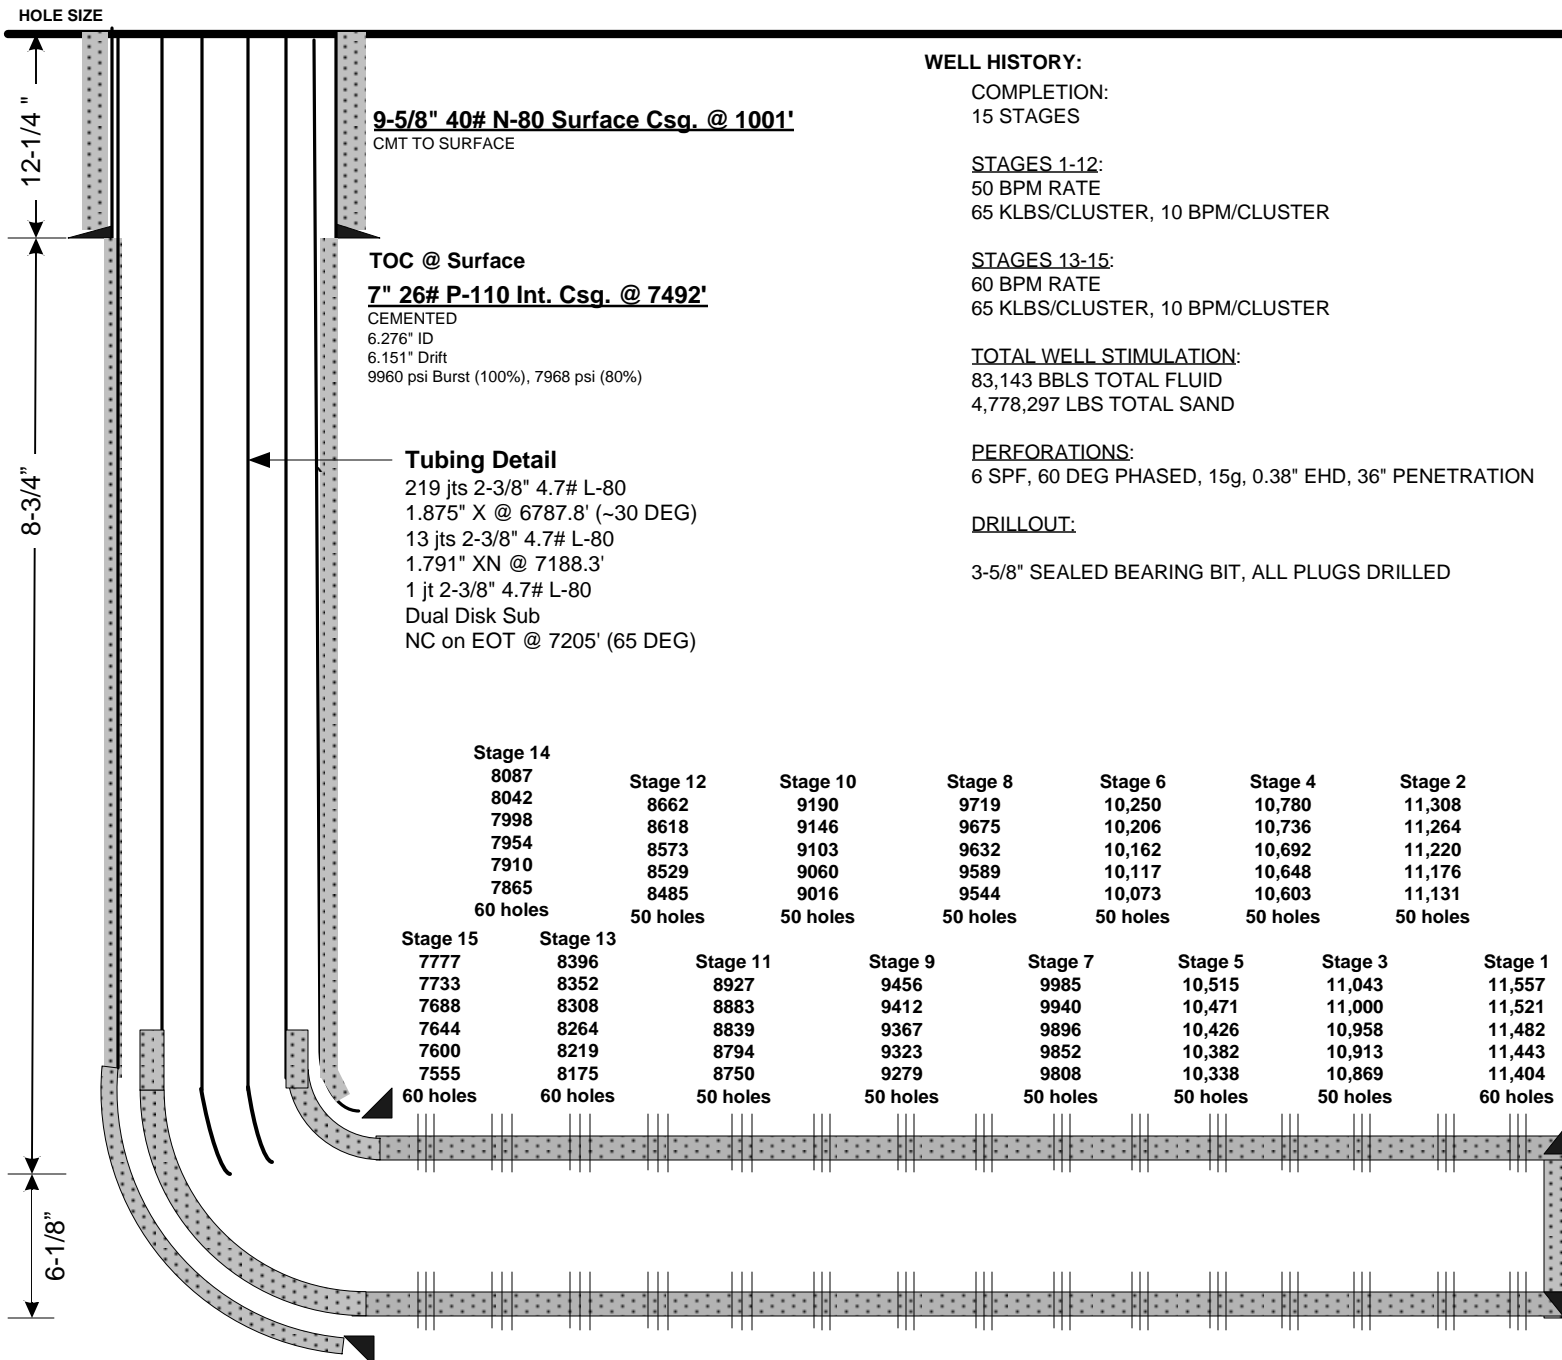

Directional Data

KOP: 6450'
 30°: 6800'
 60°: 7160'
 80°: 7370'
 90°: 8100'
 Max DLS: 11.6°/100' @ 7340' MD

Lateral Length: 4192' (Int. Shoe-TD)

4-1/2" 13.5# P-110 DQX Prod. Csg @ 11,664'

CEMENTED
 3.920" ID
 3.795" Drift
 12,410 psi Burst (100%), 9928 psi (80%)

TD: 11,684'
 PBTD (FC): 11,572'
 TVD: ~7081'
 BHT: 240 F