

KERR-MCGEE ROCKY MOUNTAIN CORP

ELKHORN CO GU 1
SW NE 21 2N 67W -- --
WELD,COLORADO
03/08/2013

AREA: S1

ROUTE: S15 Spud: 08/30/1973

WINS No.: 74825

AFE/WO#: 88273144

API#: 0512307794

GL: 5032

KB: 5044

MTD: 8230


TVD: 8230

LOG MD: 8230

PBMD: 8183

PBTVD: 8183

Directions: WCR 19 & WCR 20, W 1/4, S 1/4 INTO

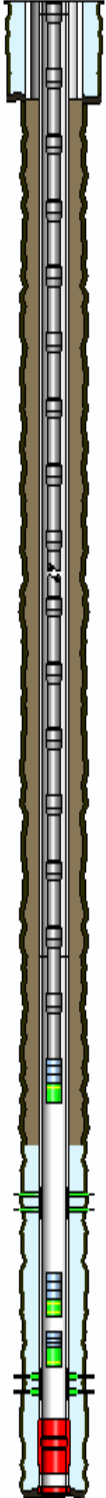

HOLE SECTIONS	Size	Top	Btm	TD Date
SURFACE	12.25	12	658	08/30/1973
PRODUCTION	7.88	658	8230	09/10/1973

TUBULARS	Tool Type	Joints	Size	Weight	Grade	Thread	Top D	Bottom D
SURFACE CASING	Casing	16	8.63	24.00	J-55	STC	12	658
PRODUCTION CASING	Casing	3	4.50	11.60	K-55	LTC	12	100
	Casing	191	4.50	10.50	K-55	LTC	100	6376
	Casing	53	4.50	11.60	K-55	LTC	6376	8183
	Casing Float Collar	1					8183	8184
	Casing	1	4.50	11.60	K-55	LTC	8184	8224
	Casing Guide Shoe	1					8224	8225
PRODUCTION TUBING	Tubing	255	2.37	4.70	J-55	External-Ups	12	8018
	Seating Nipple	1	2.38				8018	8019
	Notched Collar	1	2.38				8019	8020
PRODUCTION TUBING	Tubing	256	2.38	4.70	J55	8RD EUE	12	8061
	Seating Nipple	1	2.38				8061	8062
	Notched Collar	1	2.38				8062	8063

CEMENT JOBS	Stage	Sacks	Cement Jobs	Top D	Btm D	cbl
SURFACE CASING	Stage 1	450	LEAD REGULAR	12	658	No
PRODUCTION CASING	STAGE 1	200	LEAD 50/50 POZ-MIX	7340	8225	Yes
PRODUCTION TUBING				0	0	No

PERFORATIONS	Formation	Zone	Top	Btm	Date	Reason	Comments
	NIORARA		7310	7311	09/10/2012	CEMENT SQUEEZE	
	CODELL		7622	7642	11/19/1983	PRODUCTION	
	J SAND		8074	8114	11/19/1973	PRODUCTION	

Comments: