


# Little Beaver 24 Post P&T Config.

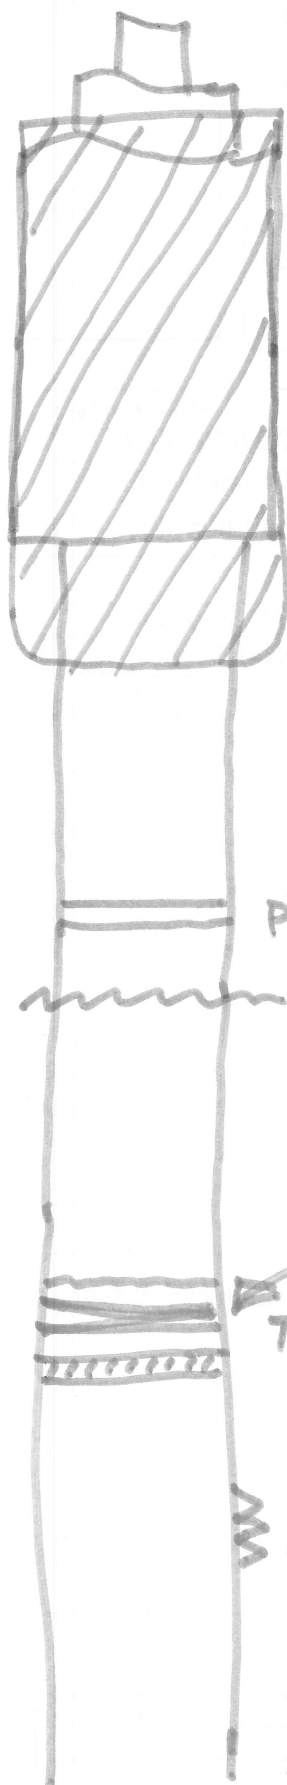

65 SX From  
157'  
to  
Surf

8 5/8  
at 107'

patch tool  
2248'

casing cut  
& recovered 2268'

CIBP + 2SX  
at 5106'

TAC  
stuck  
5100'

D sand  
perfs  
5218 -  
5268

5 1/2 Casing  
at 5307'

5320 TD