


KERR-MCGEE ROCKY MOUNTAIN CORP
UPRR 62 PAN AM "K" #1
NW NE 15 2N 65W 250' FNL 2,390' FEL
WELD,COLORADO
03/12/2013

AREA: S5 ROUTE: S54 Spud: 04/30/1977 WINS No.: 75243 AFE/WO#: 88285104 API#: 0512309185

GL: 4866 KB: 4876 MTD: 7705 TVD: 7705 LOG MD: 7701 PBMD: 7670 PBTVD: 7670

Directions: WCR 41 & WCR 22, E 1 1/2, S INTO

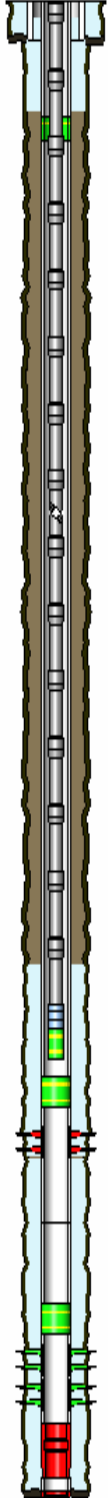

HOLE SECTIONS		Size	Top	Btm	TD Date	
SURFACE		12.25	10	255	04/30/1977	
PRODUCTION		7.88	255	7700	05/07/1977	

TUBULARS	Tool Type	Joints	Size	Weight	Grade	Thread	Top D	Bottom D
SURFACE CASING								
	Casing	6	8.63	24.00	K-55	LT&C	10	254
PRODUCTION CASING								
	Casing	24	4.50	10.50	K-55	ST&C	10	754
	Cement Stage Too	1	4.50				754	755
	Casing	201	4.50	10.50	K-55	ST&C	755	7005
	Casing	22	4.50	11.60	K-55	LT&C	7005	7668
	Casing Float Collar	1	4.50				7668	7670
	Casing	1	4.50	11.60	K-55	LT&C	7670	7704
	Casing Guide Shoe	1	4.50				7704	7705
BRIDGE PLUG								
	CIBP With Sand Cai	1	4.50				7530	7532
PRODUCTION TUBING								
	Tubing	200	2.38	4.70	J-55	8RD EUE	10	6335
	Seating Nipple	1	2.38				6335	6336
	Notched Collar	1	2.38				6336	6338
BRIDGE PLUG								
	Retrievable Bridge F	1	4.50				6450	6456

CEMENT JOBS	Stage	Sacks	Cement Jobs		Top D	Btm D	cbl
SURFACE CASING							
	STAGE 1	200	LEAD	REG	10	254	No
PRODUCTION CASING							
	STAGE 2	350	LEAD	50/50 POZMIX	115	720	Yes
	STAGE 1	250	LEAD	50/50 POZMIX	6590	7705	Yes
PRODUCTION CASING							
	REMEDIAL CEMENT	100	LEAD	50/50 POZ-MIX	6080	6581	Yes

PERFORATIONS							
Formation	Zone	Top	Btm	Date	Reason	Comments	
NIORARA		6580	6581	10/12/2012	CEMENT SQUEEZE		
J SAND		7580	7592	06/17/1977	PRODUCTION	TA BELOW CIBP	
J SAND		7612	7628	06/17/1977	PRODUCTION		

Comments: