


KERR-MCGEE ROCKY MOUNTAIN CORP
PLATTE 20-35
SE SE 35 4N 67W 1,230' FSL 1,300' FEL
WELD,COLORADO
03/11/2013

AREA: N2 **ROUTE: N21** **Spud: 10/17/2003** **WINS No.: 75538** **AFE/WO#: 88278840** **API#: 0512321619**

GL: 4750 **KB: 4762** **MTD: 7355** **TVD: 7355** **LOG MD: 7353** **PBMD: 7321** **PBTVD: 7321**

Directions: **CR 38 & CR 23, W 3/10, N 3/10, E INTO.**

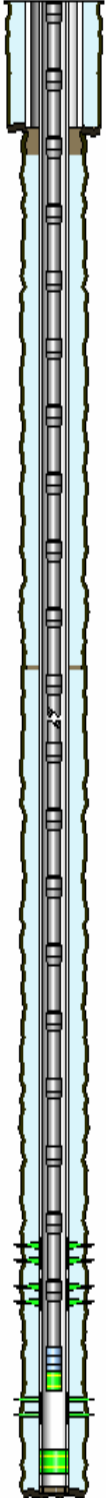

<u>HOLE SECTIONS</u>		<u>Size</u>	<u>Top</u>	<u>Btm</u>	<u>TD Date</u>			
SURFACE		12.25	12	723	10/18/2003			
PRODUCTION		7.88	723	7355	10/22/2003			
<u>TUBULARS</u>		<u>Tool Type</u>	<u>Joints</u>	<u>Size</u>	<u>Weight</u>	<u>Grade</u>	<u>Thread</u>	<u>Top D</u> <u>Bottom D</u>
SURFACE CASING		Casing	16	8.63	24	J-55		12 713
PRODUCTION CASING		Casing	174	4.50	11.6	I-80		12 7321
			1	4.50				7321 7322
		Casing	1	4.50	11.6	I-80		7322 7347
		Casing Guide Shoe	1	4.50				7347 7348
PRODUCTION TUBING		Tubing	233	2.38	4.70	J-55	External-Ups	12 7183
		Seating Nipple	1	2.38				7183 7184
		Notched Collar	1	2.38				7184 7185
<u>CEMENT JOBS</u>		<u>Stage</u>	<u>Sacks</u>	<u>Cement Jobs</u>		<u>Top D</u>	<u>Btm D</u>	<u>cbl</u>
SURFACE CASING		STAGE 1	500	NEAT		12	713	No
PRODUCTION CASING		STAGE 1 MIDDLE	95	LITE		4900	6350	Yes
		STAGE 1 TAIL 2	190	50/50 POZ-MIX		6350	7348	Yes
		STAGE 1	160	LITE		3730	4900	Yes
PRODUCTION CASING		ONE INCH JOB		PRE FLU&SMS WATER		870	3710	Yes
		ONE INCH JOB		DISPLAC&FRESH WATER		870	3710	Yes
		ONE INCH JOB		SPACER FRESH WATER		870	3710	Yes
		ONE INCH JOB		SPACER FRESH WATER		870	3710	Yes
		ONE INCH JOB	700	LEAD CEMENT		870	3710	Yes
<u>PERFORATIONS</u>		<u>Formation</u>	<u>Zone</u>	<u>Top</u>	<u>Btm</u>	<u>Date</u>	<u>Reason</u>	<u>Comments</u>
		NIORARA		6903	6909	10/30/2003	PRODUCTION	
		NIORARA		6970	6974	10/30/2003	PRODUCTION	
		CODELL		7192	7204	10/28/2003	PRODUCTION	

Comments: