

KERR-MCGEE ROCKY MOUNTAIN CORP

UPRR 62 PAN AM "D" #1

SW SW 15 2N 65W -- --

WELD,COLORADO

03/12/2013

AREA: S5

ROUTE: S51 Spud: 02/14/1974

WINS No.: 75242

AFE/WO#: 88283863

API#: 0512307868

GL: 4872

KB: 4882

MTD: 7901


TVD: 7901

LOG MD: 7907

PBMD: 7901

PBTVD: 7901

Directions: WCR 41 & WCR 20, E 1 1/10 INTO

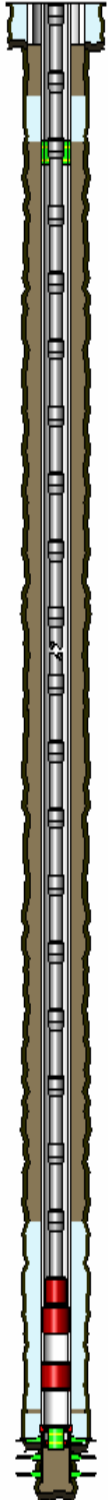

<u>HOLE SECTIONS</u>	<u>Size</u>	<u>Top</u>	<u>Btm</u>	<u>TD Date</u>				
SURFACE	12.25	10	232	02/14/1974				
PRODUCTION	7.88	232	7774	10/31/1998				
DEEPEMED	3.88	7774	7907	10/30/1998				

<u>TUBULARS</u>	<u>Tool Type</u>	<u>Joints</u>	<u>Size</u>	<u>Weight</u>	<u>Grade</u>	<u>Thread</u>	<u>Top D</u>	<u>Bottom D</u>
SURFACE CASING	Casing	5	8.63	24	K-55		10	228
PRODUCTION CASING	Casing	15	4.50	10.50	K-55	LTC	10	745
	Cement Stage Too	1	4.50				745	746
	Casing	174	4.50	10.50	K-55	LTC	746	7742
	Casing Float Collar	1					7742	7743
	Casing	1	4.50	10.50	K-55	LTC	7743	7774
	Casing Guide Shoe	1	4.50				7774	7775
SAND PLUG	Sand Plug						7050	7812
CEMENT RETAINER	Wellbore Equipment	1	4.50				6848	6849
PRODUCTION TUBING	Tubing	156	2.37	4.70	J-55	8RD EUE	10	6696
	Wellbore Equipment	1	3.13				6696	6697
	Wellbore Equipment	1	3.88				6697	6698

<u>CEMENT JOBS</u>	<u>Stage</u>	<u>Sacks</u>	<u>Cement Jobs</u>	<u>Top D</u>	<u>Btm D</u>	<u>cbl</u>
SURFACE CASING	STAGE 1	250	G	10	228	No
PRODUCTION CASING	PRIM CMT 2ND STAGI	200	50/50 POZ-MIX	500	745	Yes
	PRIM CMT 1ST STAGE	200	50/50 POZ-MIX	6970	7775	Yes
PRODUCTION CASING	SQUEEZE JOB			6400	6950	Yes

<u>PERFORATIONS</u>	<u>Formation</u>	<u>Zone</u>	<u>Top</u>	<u>Btm</u>	<u>Date</u>	<u>Reason</u>	<u>Comments</u>
	NIORARA	SQUEEZE	6400	6401	10/15/2012	CEMENT SQUEEZE	
	NIORARA	SQUEEZE	6950	6951	10/12/2012	CEMENT SQUEEZE	
	CODELL		7174	7186	02/14/1996	PRODUCTION	
	J SAND		7624	7634	03/18/1974	PRODUCTION	
	J SAND		7644	7666	03/18/1974	PRODUCTION	
	DAKOTA		7832	7876	10/31/1998	PRODUCTION	Open Hole

Comments: