

## WELLBORE SCHEMATIC


Chesnee #1

SENE, Sec. 07-14S-44W 6PM

API #: 05-017-07723-00

Kuenzler & Flora Reserve Corp (#10299)

Cheyenne Cty, CO

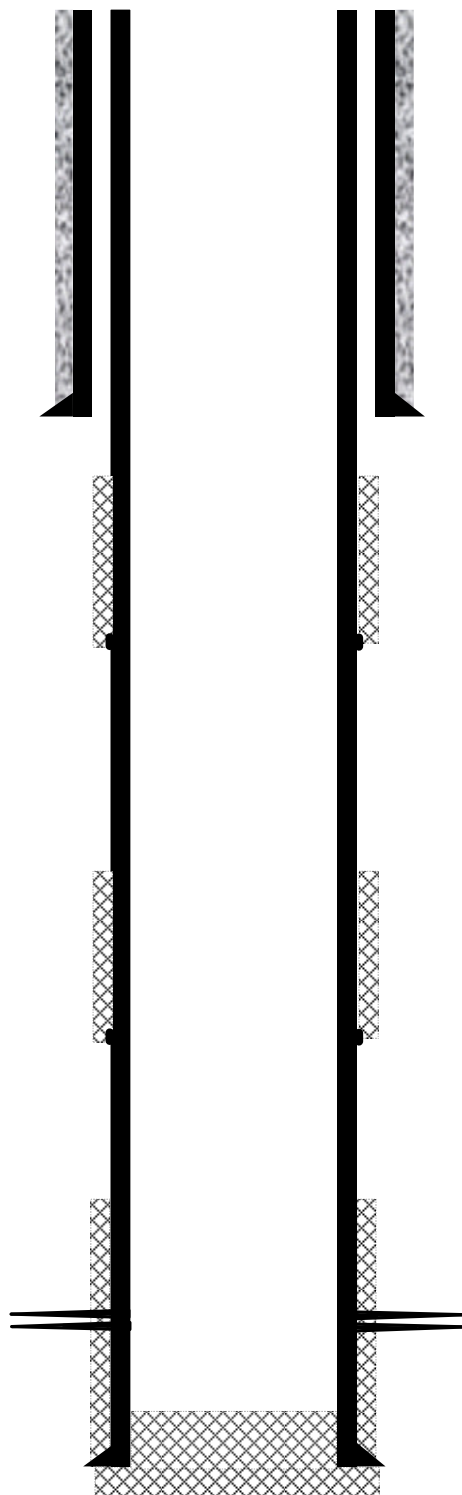

9/21/12 Spud  
10/3/12 TD

13 3/8" 54.5# @ 415' (520 sx)  
CMT to surface

Required cmt coverage: 1900'-2450'  
Cement: 325 sx  
Actual cmt coverage: 1626'-2542' (10/24/12 CBL)  
Stage Tool: 2541'

Cement: 150 sx  
Actual cmt coverage: 3980'-4380' (10/24/12 CBL)  
Stage Tool: 4265'

TOC 4410' (10/24/12 CBL)

Perforate: 5376'-5382'

PBTD 5444'  
5.5" 15.5# CSG 5474'  
CMT, 13.8# 135 sx (1.37 yield)  
TD 5488'