

Job # 12111-Harley #3


Inv # 2294

High Prairie Surveying of Kiowa, Colorado has in accordance with a request from **PRONGHORN OPERATING LLC** has determined the location of **Harley #3** to be **1869 feet FSL**, and **2013 feet FWL**, (90° off Section lines) of **SECTION 5**, Township **14s**, Range **44w** of the 6th Principal Meridian, **Cheyenne County**, Colorado.

Date: Staked on 2/12/13 drawn on 2/15/13.
Rev: Add Capped Well on 3/14/13

Re: Staked by Keith Westfall
Drawn: Drawn by Dustin Cotter

Location Drawing

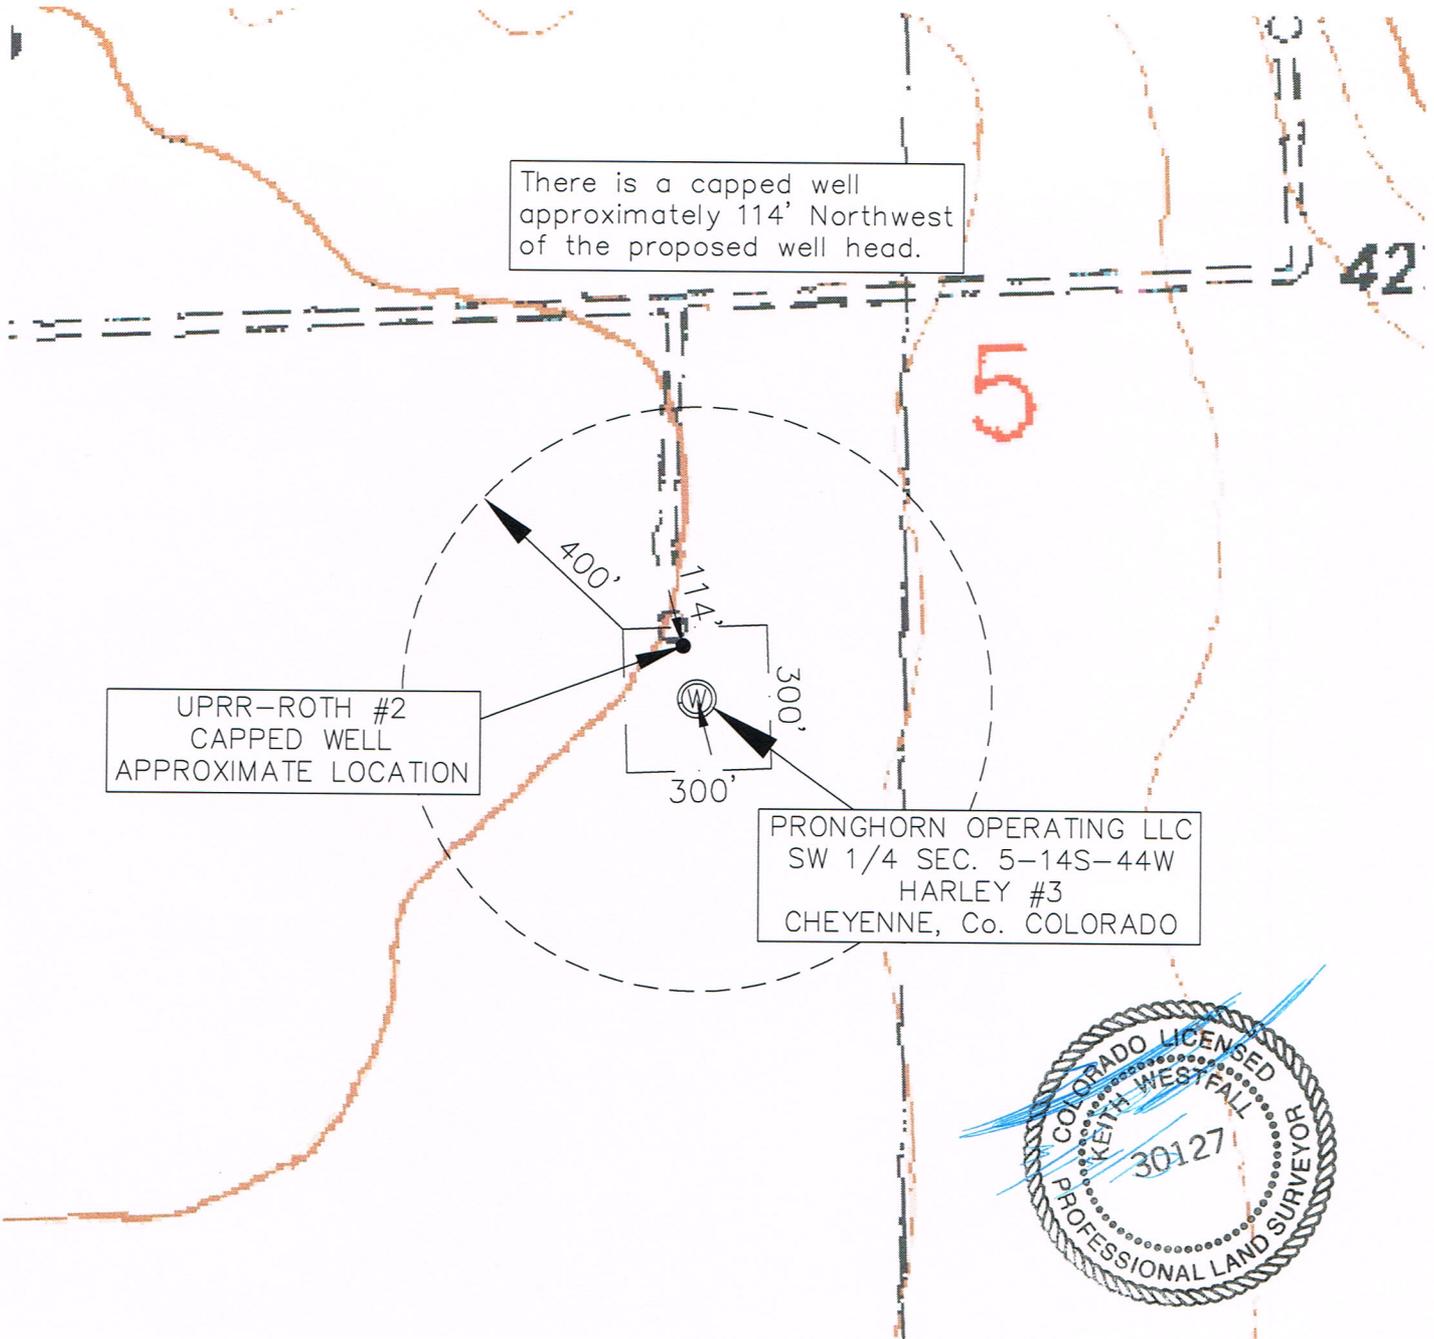

There is a capped well approximately 114' Northwest of the proposed well head.

UPRR-ROTH #2
CAPPED WELL
APPROXIMATE LOCATION

PRONGHORN OPERATING LLC
SW 1/4 SEC. 5-14S-44W
HARLEY #3
CHEYENNE, Co. COLORADO

