




Lease Name: Avex 42-10D

Legals: SWNE – Sec. 10, T4N, R68W

County: Weld County, Colorado

API#: 05-123-34998

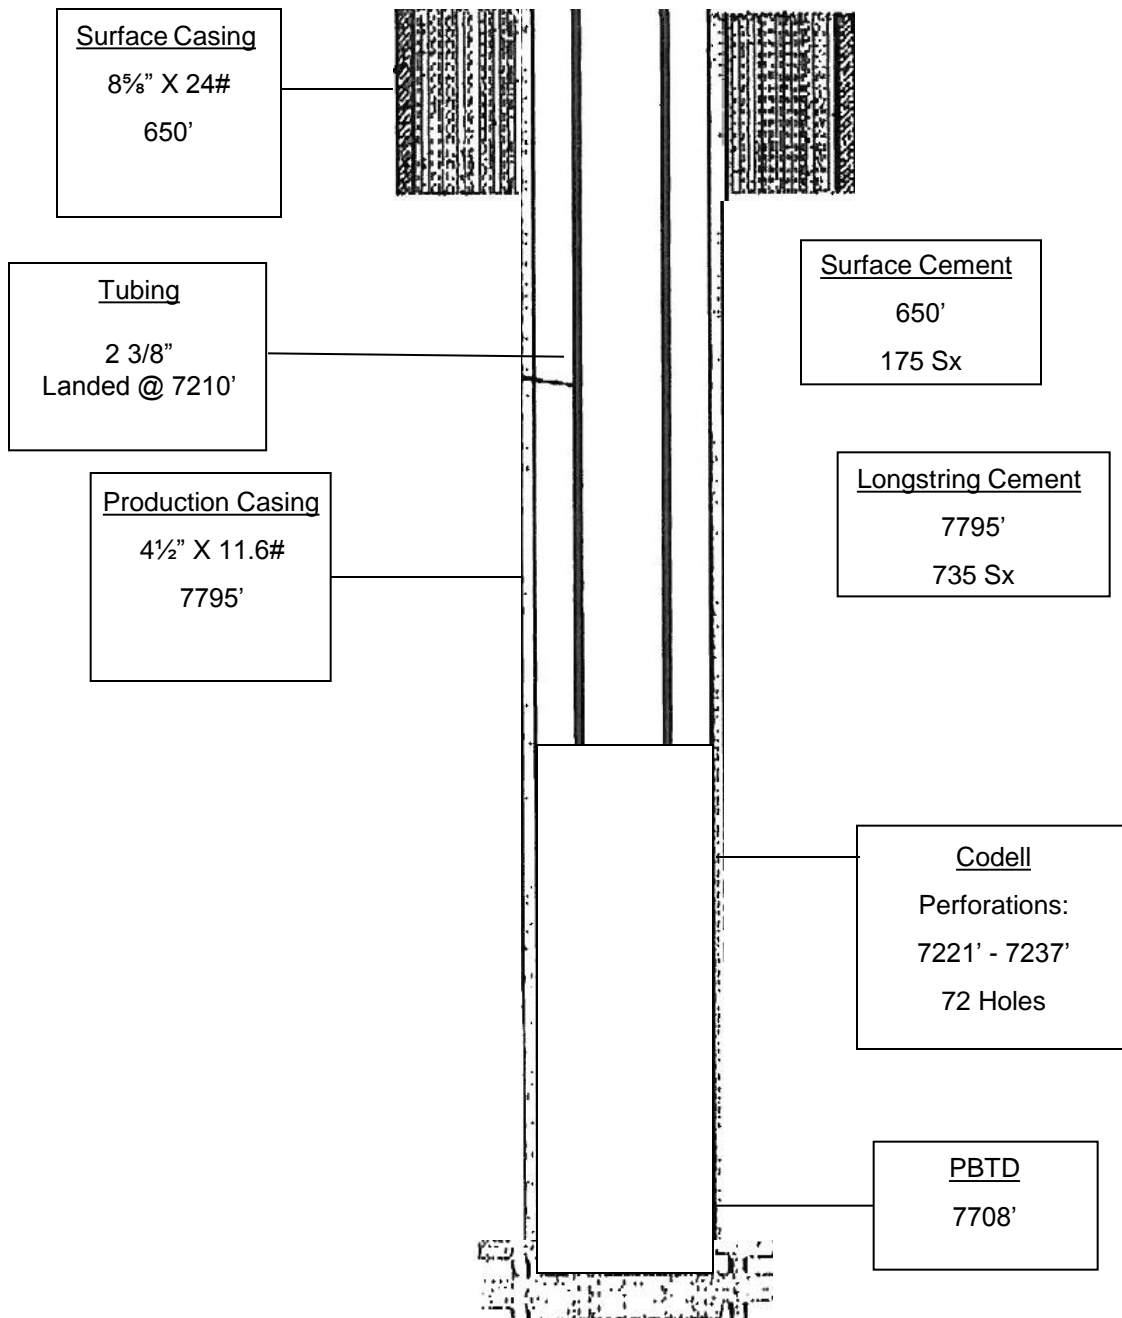

Wellbore Diagram