


KERR-MCGEE ROCKY MOUNTAIN CORP
LANSON'S FARM GAS UNIT 1
SW NE 35 2N 68W -- --
WELD, COLORADO
03/18/2013

AREA: S2 **ROUTE: S21** **Spud: 12/10/1975** **WINS No.: 74721** **AFE/WO#: 2022374** **API#: 0512308427**

GL: 4953 **KB: 4963** **MTD: 8232** **TVD: 8232** **LOG MD: 8252** **PBMD: 8173** **PBTVD: 8173**

Directions: **WCR 16 & WCR 11, W 3/10, S 4/10, N INTO**

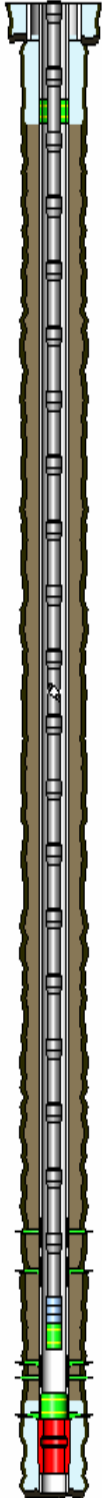

<u>HOLE SECTIONS</u>		<u>Size</u>	<u>Top</u>	<u>Btm</u>	<u>TD Date</u>				
SURFACE		12.25	10	242	12/09/1975				
PRODUCTION		7.88	234	8233	12/17/1975				
<u>TUBULARS</u>	<u>Tool Type</u>	<u>Joints</u>	<u>Size</u>	<u>Weight</u>	<u>Grade</u>	<u>Thread</u>	<u>Top D</u>	<u>Bottom D</u>	
SURFACE CASING		Casing	6	8.63			10	234	
PRODUCTION CASING		Casing	14	4.50	11.60	K55	8RD	10	583
	Cement Stage Too	1	4.50				583	584	
	Casing	184	4.50	11.60	K-55	8RD	584	8173	
	Casing Float Collar	1					8173	8174	
	Casing	1	4.50	11.60	K-55	8RD	8174	8215	
SAND PLUG		Sand Plug	1	4.00			7718	8173	
PRODUCTION BHA		Tubing	241	2.38	4.70	J-55	8RD EUE	0	7608
	Seating Nipple	1					7608	7609	
	Notched Collar	1					7609	7610	
<u>CEMENT JOBS</u>	<u>Stage</u>	<u>Sacks</u>	<u>Cement Jobs</u>			<u>Top D</u>	<u>Btm D</u>	<u>cbl</u>	
SURFACE CASING		STAGE 1	200	REGULAR		10	234	No	
PRODUCTION CASING		STAGE 1	200	LEAD	50/50 POZ-MIX	7863	8215	No	
		STAGE 2	200	TAIL	50/50 POZ-MIX	211	593	No	
PRODUCTION CASING		REMEDIAL CEMENT				0	0	No	
PRODUCTION CASING						0	0	No	
PRODUCTION CASING						0	0	No	
PRODUCTION CASING						0	0	No	
PRODUCTION CASING						0	0	No	
<u>PERFORATIONS</u>	<u>Formation</u>	<u>Zone</u>	<u>Top</u>	<u>Btm</u>	<u>Date</u>	<u>Reason</u>	<u>Comments</u>		
			245	246	04/27/2012	CEMENT SQUEEZE			
			510	511	04/26/2012	CEMENT SQUEEZE	ALL SHOTS FIRED		
SUSSEX			4370	4371	04/17/2012	CEMENT SQUEEZE			
SUSSEX			5270	5271	04/17/2012	CEMENT SQUEEZE			
NIORARA	B		7436	7448	05/02/2012	PRODUCTION	ALL SHOTS FIRED (36)		
			7470	7471	04/12/2012	CEMENT SQUEEZE	ALL SHOTS FIRED		
NIORARA	C		7520	7530	05/02/2012	PRODUCTION	ALL SHOTS FIRED (30)		
CODELL			7654	7668	05/02/2012	PRODUCTION	ALL SHOTS FIRED (56)		
J SAND			8090	8110	12/29/1975	PRODUCTION	2 SPF		

Comments: