

**AJU HJ Clar #A1**

NWSE Section 13

T1N R58W

1646 FSL x 1650 FEL

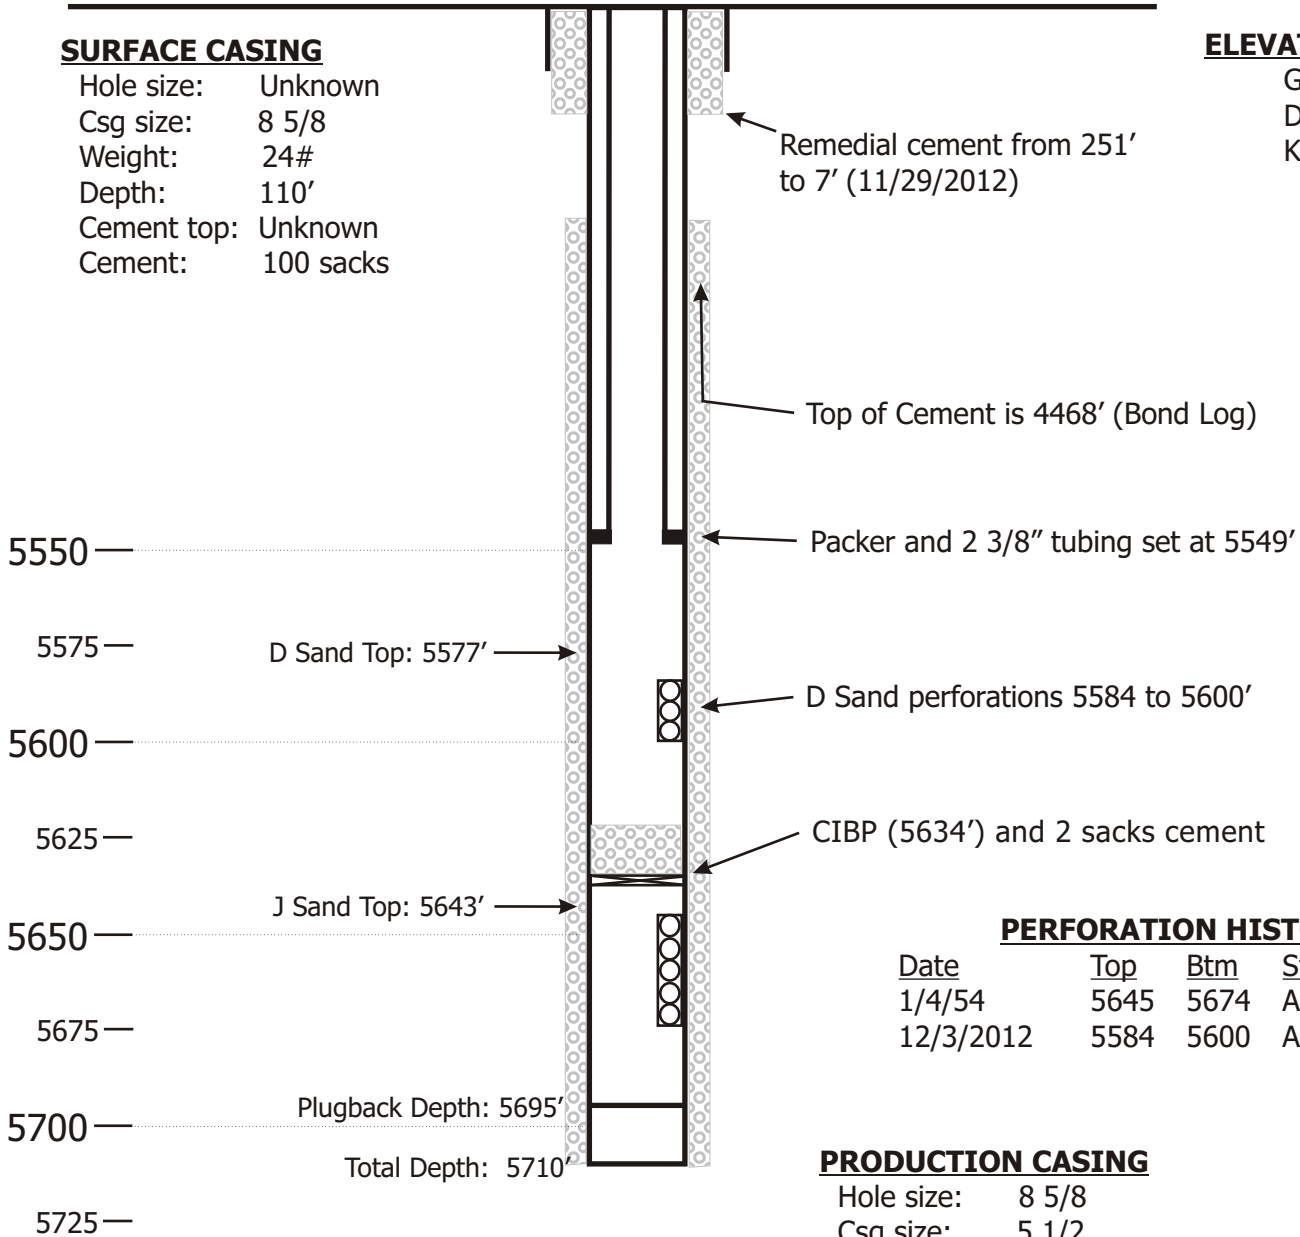
API No. 05-087-05282

**SURFACE CASING**

Hole size: Unknown  
 Csg size: 8 5/8  
 Weight: 24#  
 Depth: 110'  
 Cement top: Unknown  
 Cement: 100 sacks

**ELEVATION DATA**

GL: 4533  
 DF: 4543  
 KB: 4545

**PERFORATION HISTORY**

Date	Top	Btm	Status
1/4/54	5645	5674	Abandoned
12/3/2012	5584	5600	Active

**PRODUCTION CASING**

Hole size: 8 5/8  
 Csg size: 5 1/2  
 Weight: 15.5#  
 Depth: 5707'  
 Cement top: 4468'  
 Cement: 225 Sacks