




Parachute Creek Survey Locations




Corporate Office:
One Williams Center
Tulsa, OK. 74172
Phone: 918.573.2000

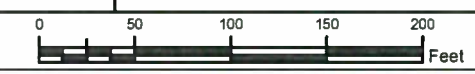

- Hydro-Vac Pot Holes
- Bores
- Hydro-Vac Trenches
- 30" Cottonwood to Parachute Plant
- 20" DeBeque Lateral
- 4" NGL Discharge Line to Bullet Tanks

1 inch = 100 feet

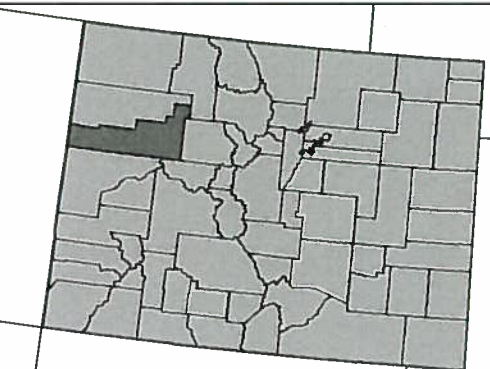

Disclaimer: For general reference purposes only.
DO NOT USE to determine, certify, or verify
map features, scale and/or other information.