


# Location Drawing

PROPOSED EXPANSION DISTURBANCE = ± 11.486 ACRES  
 EXISTING WATER FACILITY DISTURBANCE = ± 12.030 ACRES  
 TOTAL DISTURBANCE AREA = ± 23.516 ACRES

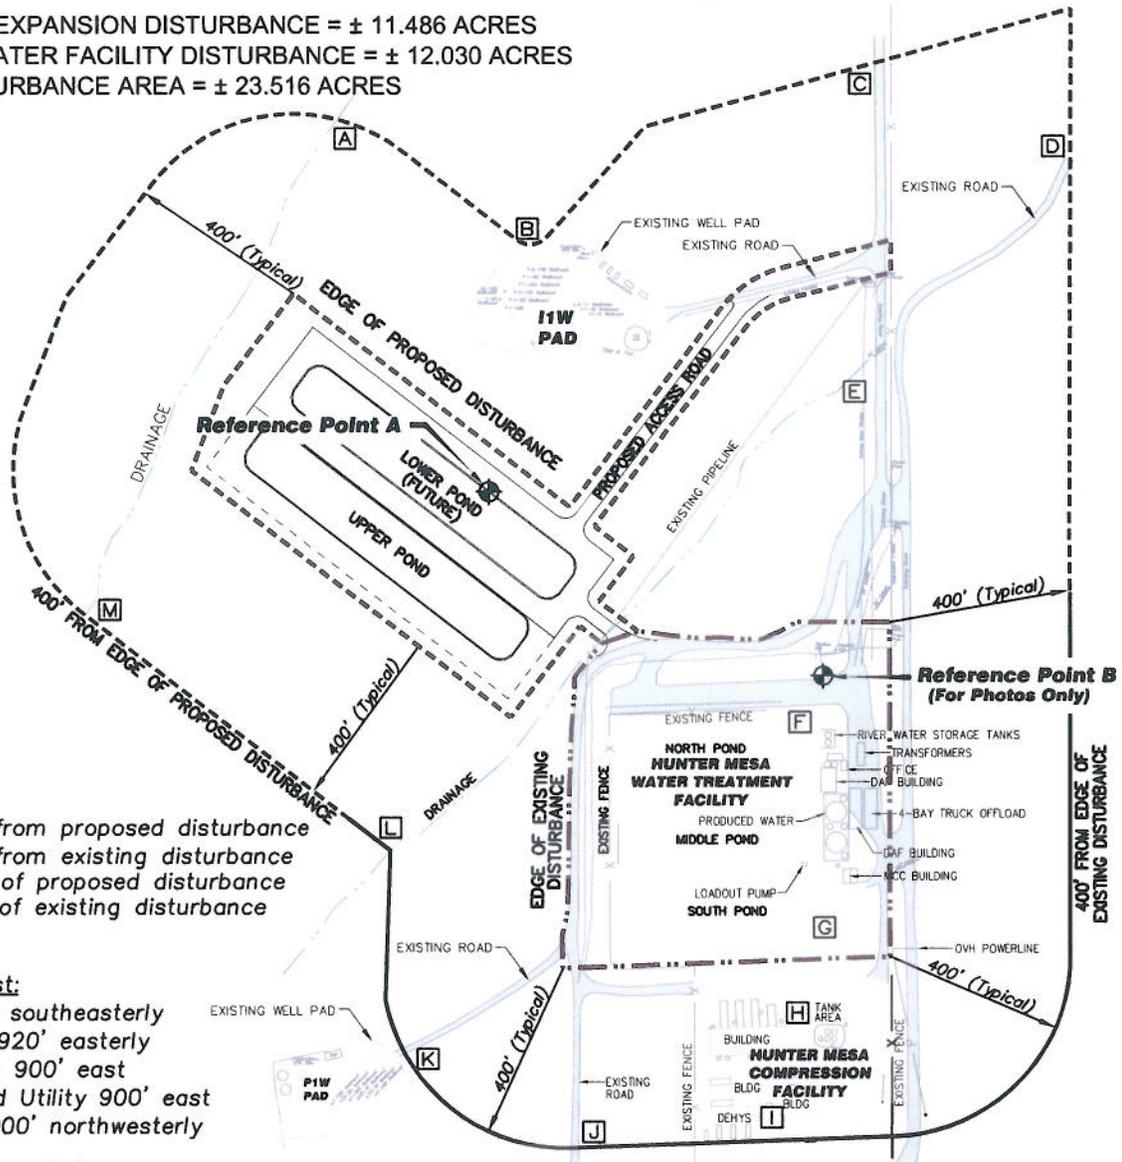

**Legend:**

- 400' from proposed disturbance
- 400' from existing disturbance
- Edge of proposed disturbance
- Edge of existing disturbance

**Tie to Nearest:**

Building 950' southeasterly  
 Public Road 920' easterly  
 Property Line 900' east  
 Above Ground Utility 900' east  
 Railroad 25,000' northwesterly

**Reference Point "A" Data:**

Latitude: N 39.472219°  
 Longitude: W 107.717734°  
 FSL: 1603'  
 FEL: 900'  
 PDOP: 3.2  
 ELEV: 6069.7'  
 Field observations taken on  
 5/10/11 by operator Jason Hergert.

**Reference Point "B" Data:**

(Used for Additional Photos Only)  
 Latitude: N 39.47110°  
 Longitude: W 107.71509°  
 PDOP: 3.2  
 ELEV: 6086.0'  
 Field observations taken on  
 6/18/12 by operator Stephen Taggart.

**Distances listed below are measured from the Reference Point "A"**

- |   |  |
|---|--|
| [A] N22°W, 895' to drainage             | [G] S38°E, 1270' to S.E. Cor. South Pond |
| [B] N08°E, 556' to edge of well pad     | [H] S29°E, 1361' to N.E. Cor. Comp Bldg. |
| [C] N42°E, 1318' to centerline road     | [I] S24°E, 1498' to S.E. Cor. Bldg.      |
| [D] N60°E, 1495' to centerline road     | [J] S08°E, 1473' to centerline road      |
| [E] N72°E, 854' to drainage             | [K] S09°W, 1260' to centerline road      |
| [F] S56°E, 873' to N.E. Cor. North Pond | [L] S15°W, 833' to drainage              |
|   | [M] S73°W, 945' to drainage              |



SCALE 1" = 400'

**Encana Oil & Gas (USA) Inc.**  
**Hunter Mesa Pond - Location Drawing**  
 Improvements extending  
 400' from disturbance

SE1/4 OF SECTION 1

T7S, R93W, 6th P.M.

GARFIELD COUNTY, COLORADO

Project No. 11-04-82 Date: June 22, 2012



906 Main Street  
 Evanston, Wyoming 82930  
 Phone No. (307) 789-4545