

WEXPRO COMPANY



CONSTRUCTION LAYOUT FOR

DONNELL #20

SECTION 6, T11N, R97W, 6th P.M.
652' FNL 1972' FWL

FIGURE #1

SCALE: 1" = 60'
DATE: 09-16-09
DRAWN BY: L.K.
REV: 12-14-09 K.G.
REV: 05-08-12 J.J.

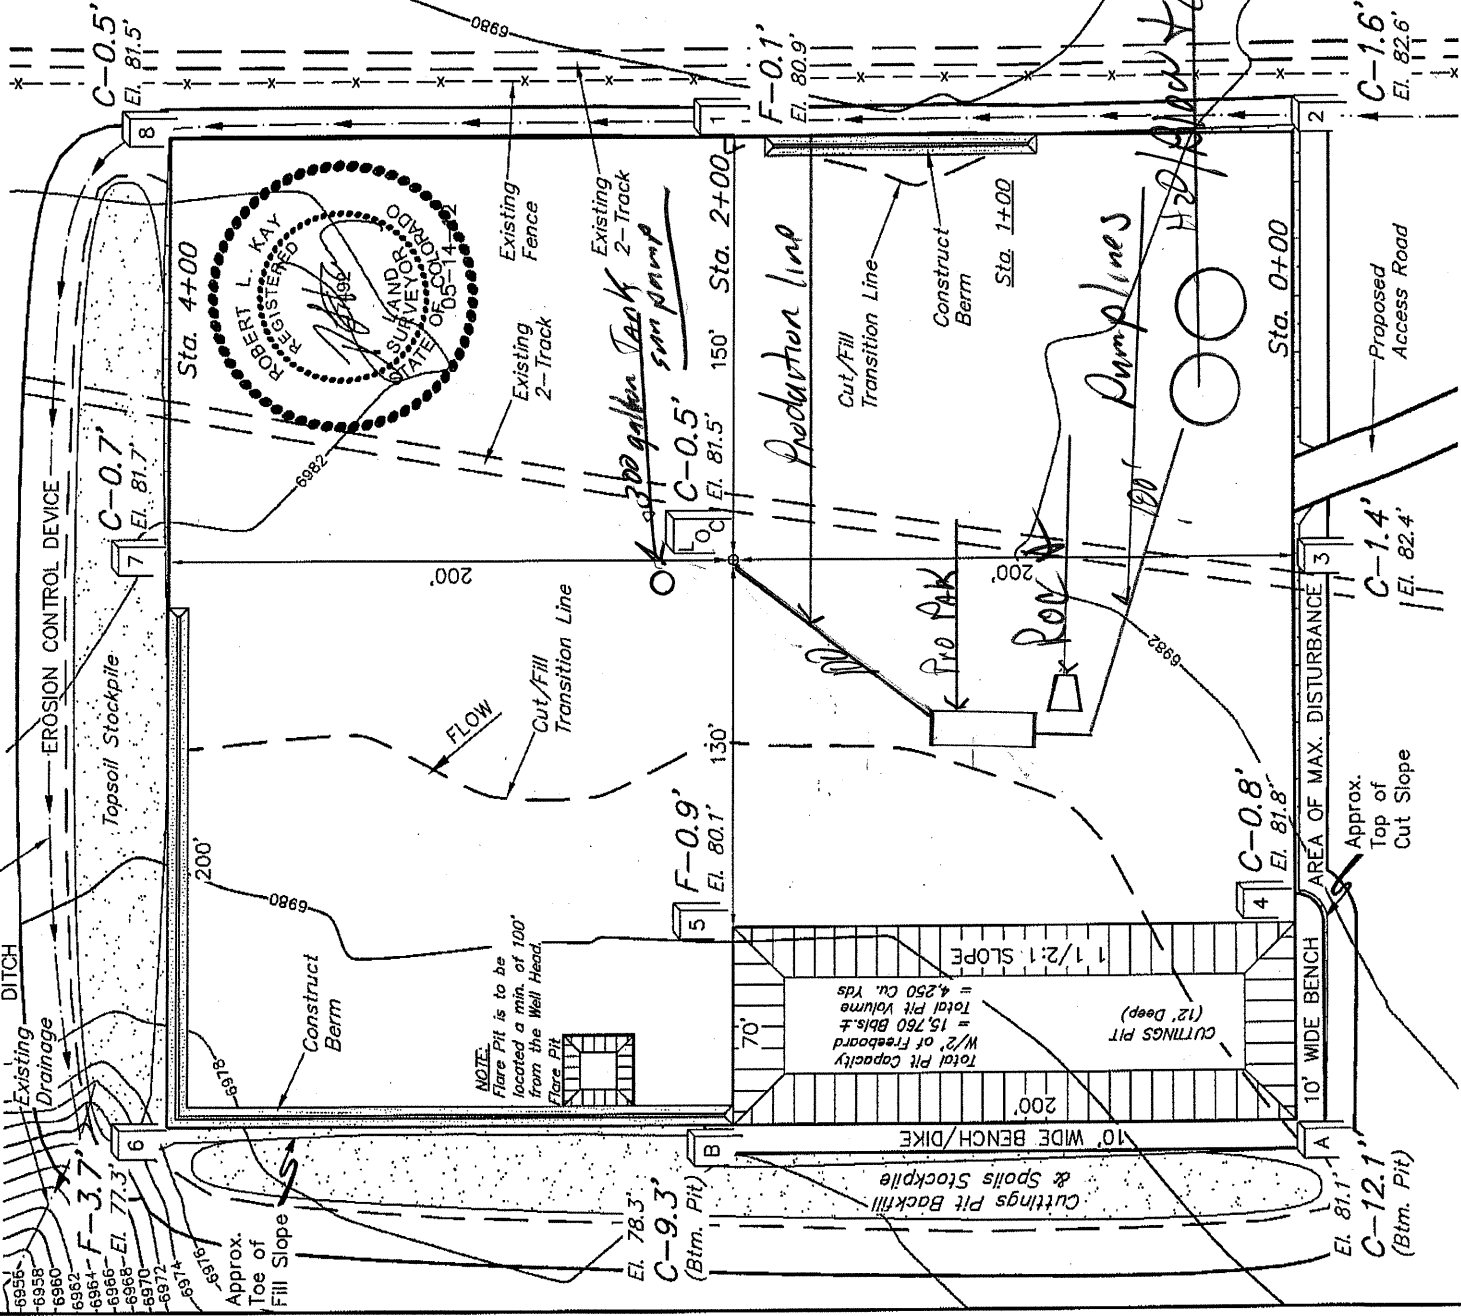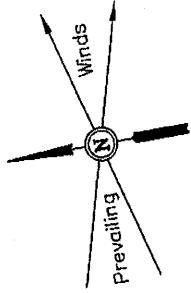

Elev. Ungraded Ground At Loc. Stake = 6981.5'
FINISHED GRADE ELEV. AT LOC. STAKE = 6981.0'

UINIAH ENGINEERING & LAND SURVEYING
85 So. 200 East * Vernal, Utah 84078 * (435) 789-1017