

Well

Operator

Location

County

State

Field

Footages

API#: 05-123-34131-00

FILE 8-2-17

EnCana Oil & Gas (USA) Inc.

NWNE Section 17-T2N-R68W

WELD

Colorado


Wattenberg

1079' FNL & 1700' FEL

Spud Date: 02-19-2012

Log Tops

Sussex	4336'
Niobrara	7451'
Codell	7712'
J Sand	8139'

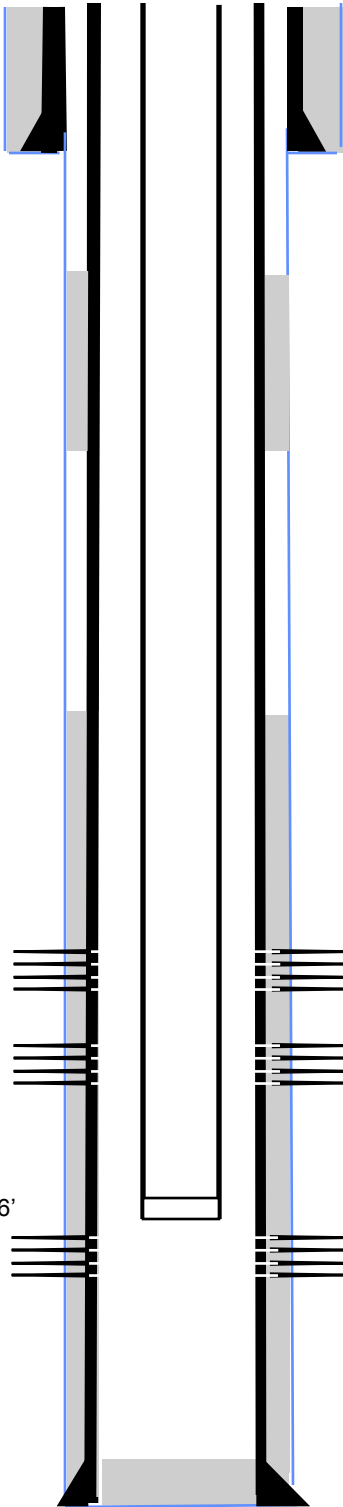

**Surface Casing and Cement**  
8 5/8" , landed @ 1006',cemented with 415 sxs

**Main Hole**  
7-7/8" to TD

**Production Casing and Cement**  
4-1/2", landed @ 8256',cemented with 691 sxs

**CBP**  
Set @ 7450'. 10-13-12  
Drilled out on 10-16-12

Perf'd the Niobrara 7488'-7500' @ 4 spf  
Frac'd the Niobrara 7488'-7500', (48 holes), w/ 97,482 gals 18 # Vistar Hybrid cross linked gel containing 250,520 # 30/50 sand. 09-24-12

**CFP**  
Set @ 7550'. 09-24-12  
Drilled out on 10-16-12

Perf'd the Codell from 7712'-7726' @ 3 spf  
Frac'd the Codell 7712'-7726' (42 holes) w/ 87,990 gal 22# Vistar Hybrid cross linked gel containing 250,200 # 30/50 sand. 09-24-12

**CFP**  
Set @ 7780'. 09-23-12  
Drilled out on 10-16-12

Perf'd the J Sand from 8151'-8172' @ 2 spf  
Frac'd the J-Sand 8151'-8172', (42 holes)w/ 64,302 gal 18 # Vistar Hybrid cross linked gel containing 250,160 # 20/40 Sand.09-23-12

**Production Tubing**  
2-3/8" tubing, set @ 8138.56'

8273' — Driller's TD