


**Well** FILE 1-17  
**Operator** EnCana Oil & Gas (USA) Inc.  
**Location** NWNE Section 17-T2N-R68W  
**County** WELD  
**State** Colorado  
**Field** Wattenberg  
**Footages** 1086' FNL & 1693' FEL  
**API#:** 05-123-34128-00

**Spud Date:** 02-27-2012

**Log Tops**

Sussex	4096'
Niobrara	7156'
Codell	7435'
J Sand	7858'

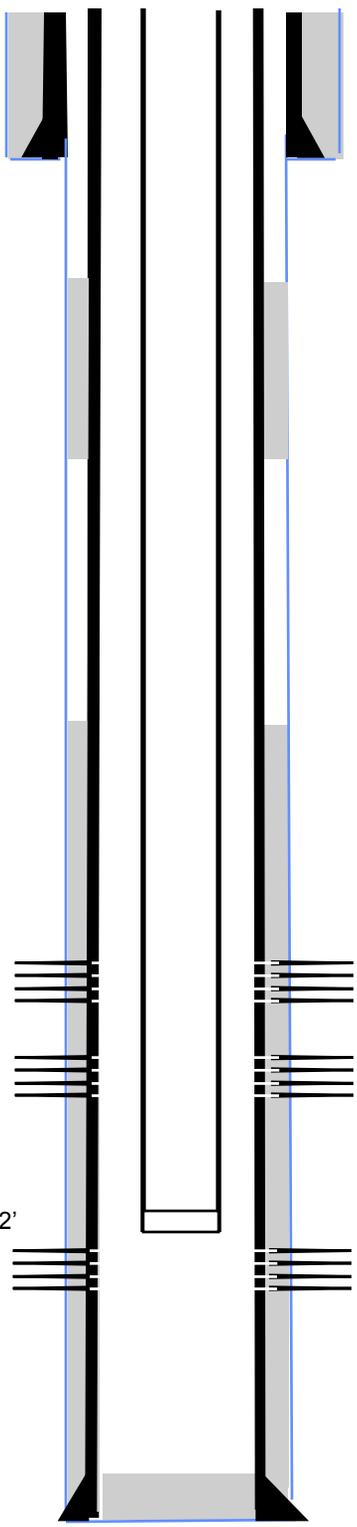

**Surface Casing and Cement**  
 8 5/8", landed @ 1006', cemented with 410 sxs

**Main Hole**  
 7-7/8" to TD

**Production Casing and Cement**  
 4-1/2", landed @ 8008', cemented with 660 sxs

**CBP**  
 Set @ 7170'. 10-12-12  
 Drilled out on 10-13-12

Perf'd the Niobrara from 7215'-7227' @ 4 spf  
 Frac'd the Niobrara 7215'-7227', (48 holes), w/ 97,440 gals 18 # Vistar Hybrid cross linked gel containing 250,120 # 30/50 sand. 09-24-12

**CFP**  
 Set @ 7620'. 09-24-12  
 Drilled out on 10-13-12

Perf'd the Codell from 7437'-7451' @ 3 spf  
 Frac'd the Codell 7437'-7451' (42 holes) w/ 88,116 gal 22# Vistar Hybrid cross linked gel containing 250,360 # 30/50 sand. 09-24-12

**CFP**  
 Set @ 7500'. 09-23-12  
 Drilled out on 10-13-12

Perf'd the J Sand from 7869'-7893' @ 2 spf  
 Frac'd the J-Sand 7869'-7893', (48 holes) w/ 63,62gal 18 # Vistar Hybrid cross linked gel containing 250,280 # 20/40 Sand. 09-23-12

**Production Tubing**  
 2-3/8" tubing, set @ 7847.12'

8008' — Driller's TD