


Well Name: BOLET RED X15-10JI

VERTICAL - ORIGINAL HOLE, 3/26/2013 4:44:01 PM

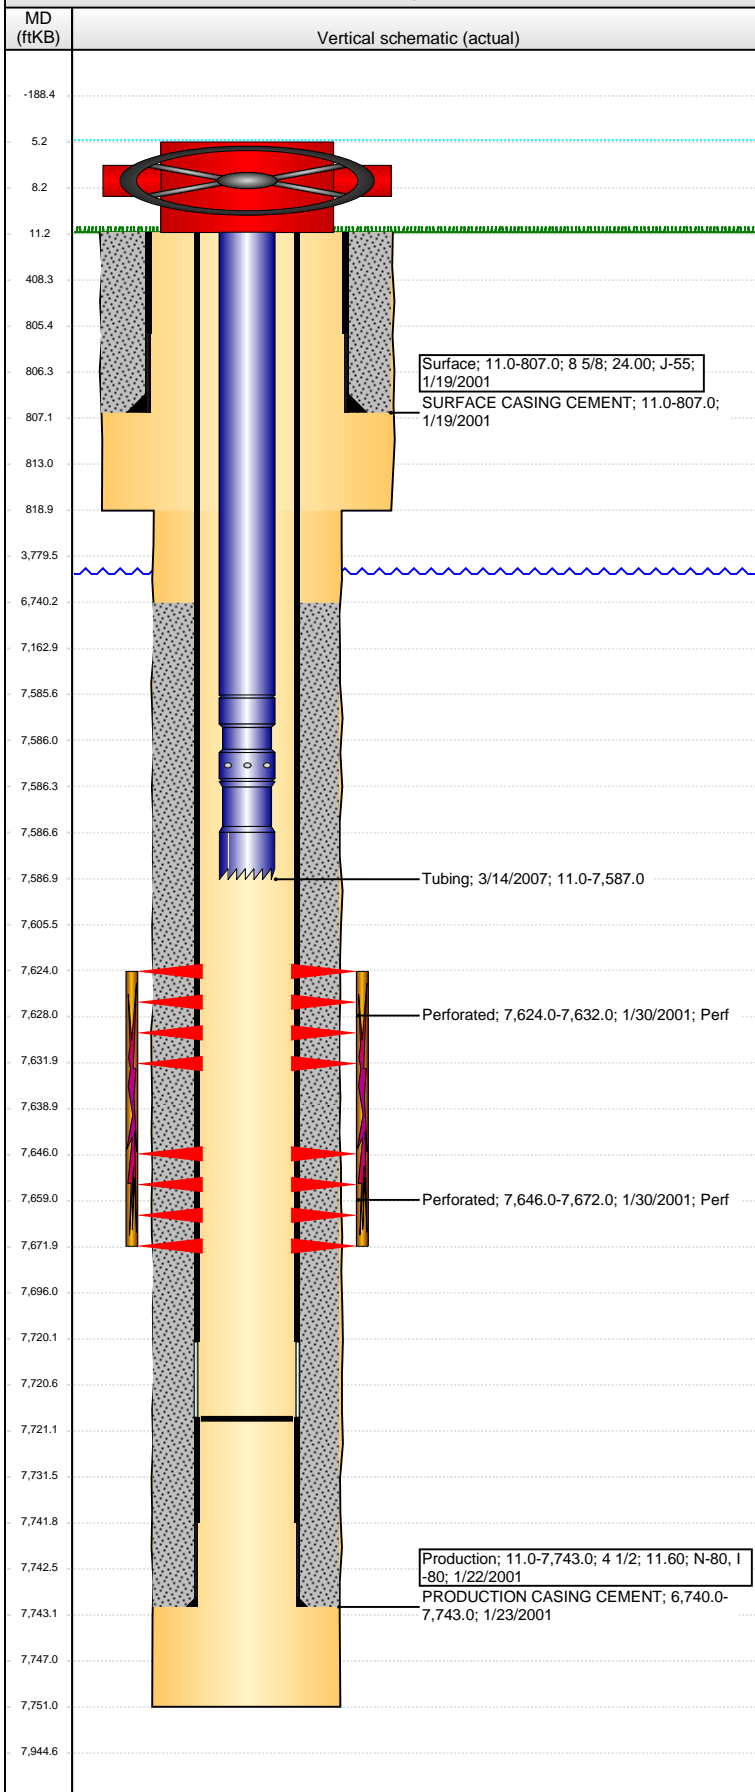

Well Header

API 05-123-20141	Business Unit WATTENBERG	District 15	Well Config VERTICAL
Original KB Elevation (ft) 4,891.00	KB - GL / MSL (ftKB) 11.00	Spud Date 1/17/2001	P & A Date
Comment			

Directions To Well

Congressional Location

Quarter 1	Quarter 2	Quarter 3 NW	Quarter 4 SE	Section 15	Township 2 N	Twntshp N...	Range 65	Rng E/W Dir W
-----------	-----------	-----------------	-----------------	---------------	-----------------	--------------	-------------	------------------

Bottom Hole Location

North-South Distance (ft)	From N or S Line	East-West Distance (ft)	From E or W Line
---------------------------	------------------	-------------------------	------------------

Plug Back Total Depths

Date	Depth (ftKB)	Method	Com
1/22/2001	7,721.0	TAG	

Wellbore Sections

Section Des	Size (in)	Act Top (ftKB)	Act Btm (ftKB)
SURFACE	12 1/4	11.0	819.0
PRODUCTION	7 7/8	819.0	7,751.0

Zone Statuses

Zone Name	Status Date	Status	Job
J SAND	2/6/2001	PR	DRILLING - ORIGINAL, 1/17/2001 00:00

Casing Strings

Surface, 807.0ftKB

Casing Description	Run Date	OD (in)	Wt/Len (l...)	Grade	Top (ftKB)	MD (ftKB)
Surface	1/19/2001	8 5/8	24.00	J-55	11.0	807.0

Production, 7,743.0ftKB

Casing Description	Run Date	OD (in)	Wt/Len (l...)	Grade	Top (ftKB)	MD (ftKB)
Production	1/22/2001	4 1/2	11.60	I-80	11.0	7,743.0

Cement

Description	Top Depth (ftKB)	Bottom Depth (ftKB)
SURFACE CASING CEMENT	11.0	807.0
PRODUCTION CASING CEMENT	6,740.0	7,743.0

Tubing Components

Item Des	OD (in)	Wt (lb/ft)	Grade	Jts	Len (ft)	Btm (ftKB)	Btm (TVD) (ftKB)
Tubing	2 3/8	4.70	J-55	248	7,574.50	7,585.5	
Seal Nipple	2 3/8			1	0.75	7,586.2	
Notched collar	2 3/8			1	0.75	7,587.0	

Perforation Data

Zone	Bnch/St g	Entered Shot Total	Top (ftKB)	Btm (ftKB)	Date
J SAND, ORIGINAL HOLE		16	7,624.00	7,632.00	1/30/2001
J SAND, ORIGINAL HOLE		52	7,646.00	7,672.00	1/30/2001

Stimulations & Treatments

Date	Zone	Primary Job Type
2/1/2001	J SAND, ORIGINAL HOLE	DRILLING - ORIGINAL
Technical Result	Tech Result Details	Tech Result Note

Comment

Other In Hole

Run Date	Des	OD (in)	Top (ftKB)	Btm (ftKB)

Logs

Date	Type	Top (ftKB)	Btm (ftKB)
1/22/2001	COMPENSATED DENSITY	4,400.0	7,731.0
1/22/2001	INDUCTION	807.0	7,751.0
1/30/2001	CBL/CCL/GR	6,450.0	7,714.0
7/6/2012	GYRO	10.0	7,550.0