


Final Well Report Detailed (graphic)

Well Name: SG 8516A-21 N22 496

API # 05045210360000	Well Type Gas	Business Unit Southern Rockies	SBU North Piceance	Area Story Gulch	Pad N22 496	State CO	County/Parish GARFIELD
-------------------------	------------------	-----------------------------------	-----------------------	---------------------	----------------	-------------	---------------------------

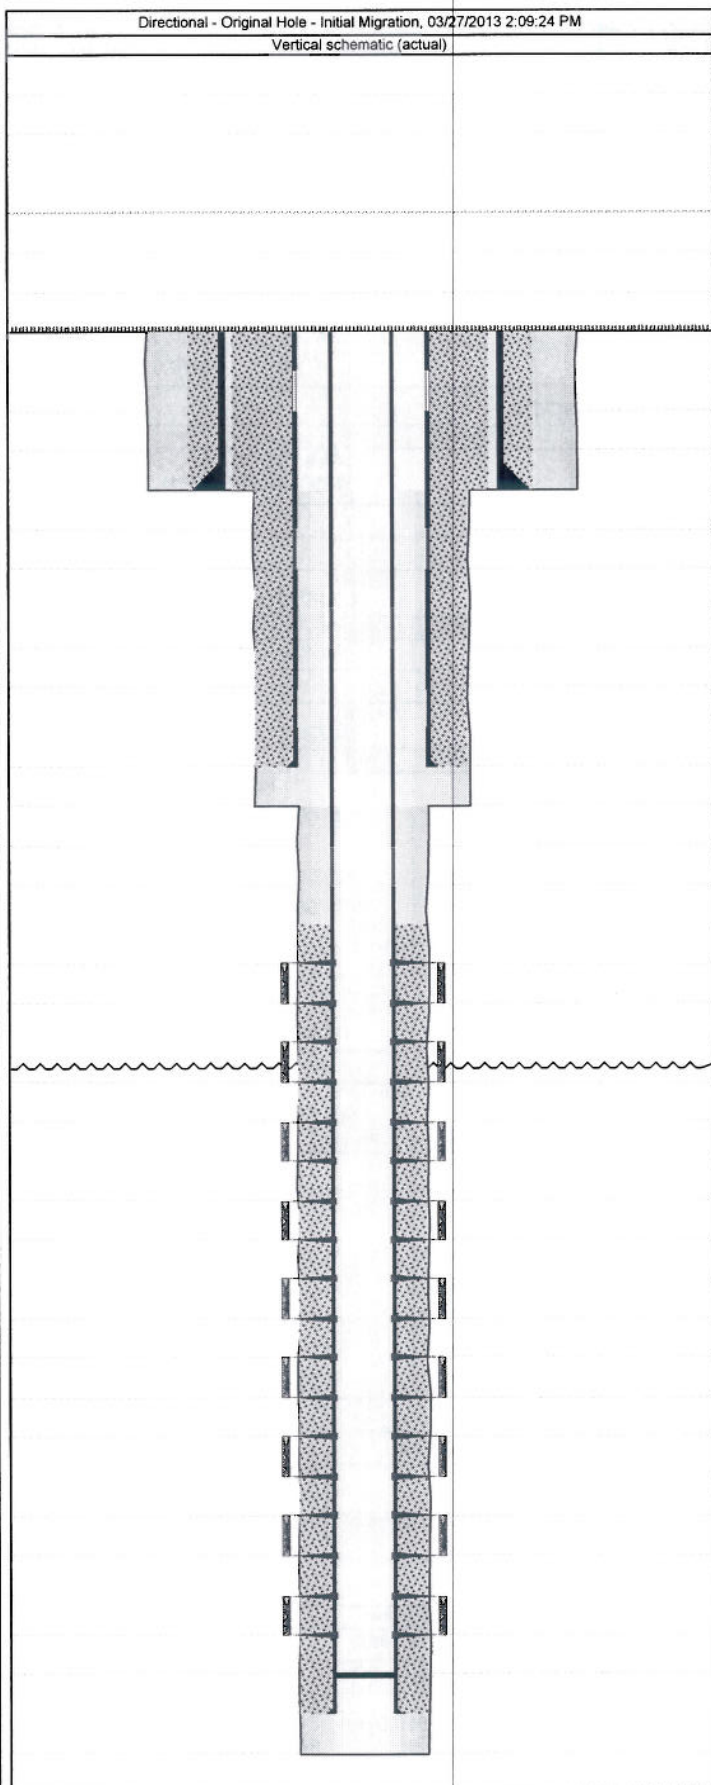


Stg # 1	Description Surface	Top (ftKB) 22.0	Btm (ftKB) 2,050.0	Full Return?
Sequence		Fluid Des	Amount (sacks)	Class
Lead		11# LiteFIL	471	
Tail		12.5# LiteFIL	246	
Production, 11,712.0ftKB Proposed? No				
Description Production Casing Cement		String Production, 11,712.0ftKB Proposed? No	Wellbore Original Hole - Initial Migration	Type Casing
Stg # 1	Description Production	Top (ftKB) 5,670.0	Btm (ftKB) 11,712.0	Full Return?
Sequence		Fluid Des	Amount (sacks)	Class
Tail		13ppg Rockies Correct GMS Enc	635	
Fill		11ppg TXI Lead #1	795	
Lead		12ppg TXI Lead #2	700	
Tubing Data				
Tubing Description		Tubing Set Date	Set Depth (ftKB)	
Item Des	OD (in)	ID (in)	Len (ft)	
Rod Data				
Rod Description		Run Date	Set Depth (ftKB)	
Item Des	OD (in)	Len (ft)		
Zones				
Zone Name Original Migration		Wellbore Original Hole - Initial Migration	Top Depth (ftKB)	Btm (ftKB)
Cur Stat Date	Current Status	Formation(s)		
Perforation Data				
Stage # 9	Type Perforated	Top Depth (ftKB) 7,867.0	Bottom Depth (ftKB) 8,160.0	Zone Original Migration, Original Hole - Initial Migration
Stage # 8	Type Perforated	Top Depth (ftKB) 8,202.0	Bottom Depth (ftKB) 8,497.0	Zone Original Migration, Original Hole - Initial Migration
Stage # 7	Type Perforated	Top Depth (ftKB) 8,528.0	Bottom Depth (ftKB) 8,910.0	Zone Original Migration, Original Hole - Initial Migration
Stage # 6	Type Perforated	Top Depth (ftKB) 8,942.0	Bottom Depth (ftKB) 9,335.0	Zone Original Migration, Original Hole - Initial Migration
Stage # 5	Type Perforated	Top Depth (ftKB) 9,389.0	Bottom Depth (ftKB) 9,778.0	Zone Original Migration, Original Hole - Initial Migration
Stage # 4	Type Perforated	Top Depth (ftKB) 9,830.0	Bottom Depth (ftKB) 10,186.0	Zone Original Migration, Original Hole - Initial Migration
Stage # 3	Type Perforated	Top Depth (ftKB) 10,223.0	Bottom Depth (ftKB) 10,596.0	Zone Original Migration, Original Hole - Initial Migration
Stage # 2	Type Perforated	Top Depth (ftKB) 10,679.0	Bottom Depth (ftKB) 11,018.0	Zone Original Migration, Original Hole - Initial Migration
Stage # 1	Type Perforated	Top Depth (ftKB) 11,127.0	Bottom Depth (ftKB) 11,465.0	Zone Original Migration, Original Hole - Initial Migration
Other In Hole				
OD (in)	Des	Top (ftKB)	Btm (ftKB)	ID (in)
Make				
Model				
Wellhead Description				
Install Date	Type	Make	Size (in)	WP (psi)

Final Well Report Detailed (graphic)

Well Name: SG 8516A-21 N22 496

API # 05045210360000	Well Type Gas	Business Unit Southern Rockies	SBU North Piceance	Area Story Gulch	Pad N22 496	State CO	County/Parish GARFIELD
-------------------------	------------------	-----------------------------------	-----------------------	---------------------	----------------	-------------	---------------------------

Directional - Original Hole - Initial Migration 03/27/2013 2:09:24 PM
Vertical schematic (actual)

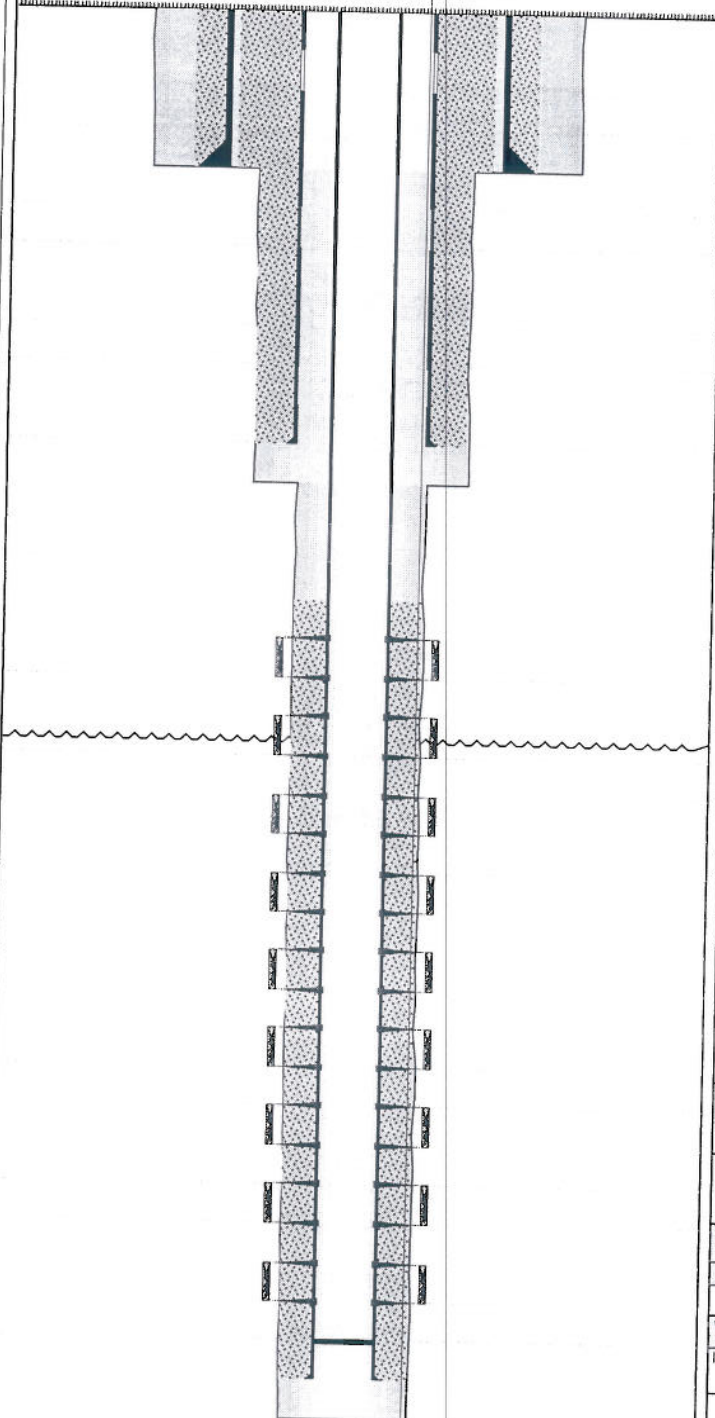

Stg # 1	Description Surface	Top (ftKB) 22.0	Btm (ftKB) 2,050.0	Full Return?
Sequence	Fluid Des	Amount (sacks)	Class	
Lead	11# LiteFIL	471		
Tail	12.5# LiteFIL	246		

Production, 11,712.0ftKB Proposed? No

Description Production Casing Cement	String Production, 11,712.0ftKB Proposed? No	Wellbore Original Hole - Initial Migration	Type Casing
---	---	--	----------------

Stg # 1	Description Production	Top (ftKB) 5,670.0	Btm (ftKB) 11,712.0	Full Return?
Sequence	Fluid Des	Amount (sacks)	Class	
Tail	13ppg Rockies Correct GMS Enc	635		
Fill	11ppg TXI Lead #1	795		
Lead	12ppg TXI Lead #2	700		

Tubing Data

Tubing Description	Tubing Set Date	Set Depth (ftKB)
Item Des	OD (in)	ID (in)
		Len (ft)

Rod Data

Rod Description	Run Date	Set Depth (ftKB)
Item Des	OD (in)	Len (ft)

Zones

Zone Name Original Migration	Wellbore Original Hole - Initial Migration	Top Depth (ftKB)	Btm (ftKB)
Cur Stat Date	Current Status	Formation(s)	

Perforation Data

Stage #	Type	Top Depth (ftKB)	Bottom Depth (ftKB)	Zone
9	Perforated	7,867.0	8,160.0	Original Migration, Original Hole - Initial Migration
8	Perforated	8,202.0	8,497.0	Original Migration, Original Hole - Initial Migration
7	Perforated	8,528.0	8,910.0	Original Migration, Original Hole - Initial Migration
6	Perforated	8,942.0	9,335.0	Original Migration, Original Hole - Initial Migration
5	Perforated	9,389.0	9,778.0	Original Migration, Original Hole - Initial Migration
4	Perforated	9,830.0	10,186.0	Original Migration, Original Hole - Initial Migration
3	Perforated	10,223.0	10,596.0	Original Migration, Original Hole - Initial Migration
2	Perforated	10,679.0	11,018.0	Original Migration, Original Hole - Initial Migration
1	Perforated	11,127.0	11,465.0	Original Migration, Original Hole - Initial Migration

Other In Hole

OD (in)	Des	Top (ftKB)	Btm (ftKB)	ID (in)	Make	Model
---------	-----	------------	------------	---------	------	-------

Wellhead Description

Install Date	Type	Make	Size (in)	WP (psi)
--------------	------	------	-----------	----------