


WELL LOCATION CERTIFICATE

THIS MAP DOES NOT REPRESENT A BOUNDARY SURVEY

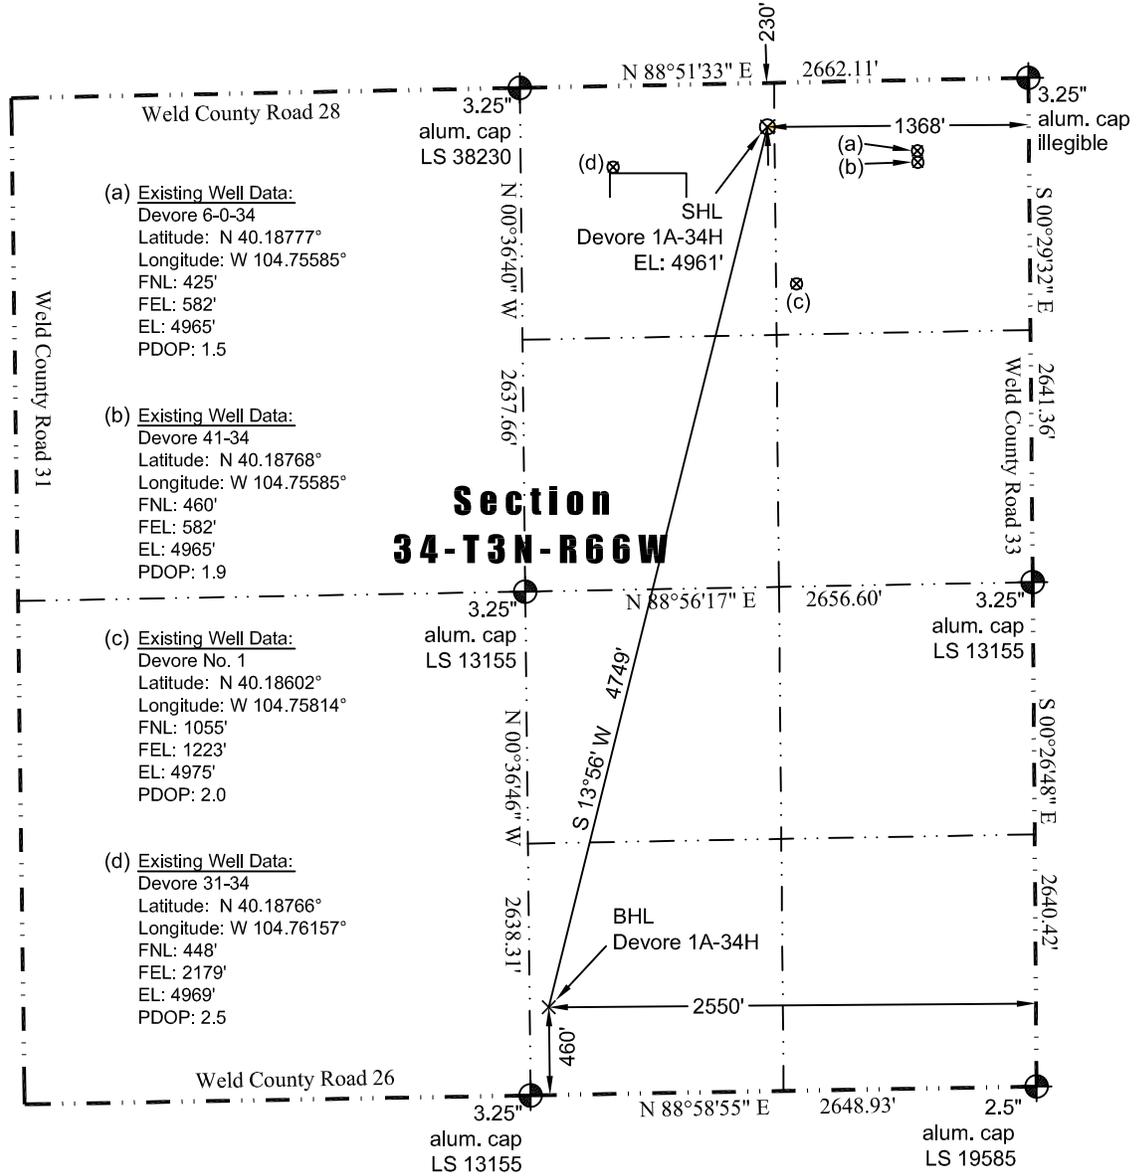

(a) Existing Well Data:
Devore 6-0-34
Latitude: N 40.18777°
Longitude: W 104.75585°
FNL: 425'
FEL: 582'
EL: 4965'
PDOP: 1.5

(b) Existing Well Data:
Devore 41-34
Latitude: N 40.18768°
Longitude: W 104.75585°
FNL: 460'
FEL: 582'
EL: 4965'
PDOP: 1.9

(c) Existing Well Data:
Devore No. 1
Latitude: N 40.18602°
Longitude: W 104.75814°
FNL: 1055'
FEL: 1223'
EL: 4975'
PDOP: 2.0

(d) Existing Well Data:
Devore 31-34
Latitude: N 40.18766°
Longitude: W 104.76157°
FNL: 448'
FEL: 2179'
EL: 4969'
PDOP: 2.5

Section 34-T3N-R66W

Scale = 1" = 1000'
approximate scale

LEGEND
— found survey monument
- - - calculated dimension
⊙ (c)


In accordance with a request from Jay Knutson of EnCana Oil & Gas (USA) Inc., JR Land Surveying, LLC has determined the location of the **Devore 1A-34H** well site to be SHL: 230' FNL and 1368' FEL, (BHL: 460' FSL and 2550' FEL), as measured at ninety (90) degrees from the section lines of Section 34, Township 3 North, Range 66 West, 6th Principal Meridian, Weld County, CO.

Proposed Surface Hole Data:
Latitude: N 40.18828° (BHL: 40.17565°)
Longitude: W 104.75866° (BHL: 104.76290°)
PDOP: 1.7

Nearest:
Building: 1,334' west
Public Road: 230' north
Property Line: 230' north
Existing Well: Devore 6-0-34, 808' southeast

Above Ground Utility: 257' north
Railroad: 16,675' southwest
Well Window: SHL is 488' outside

I hereby certify that this Well Location Certificate was prepared by me or under my direct supervision on 1/18/2013 for and on behalf of EnCana Oil & Gas (USA) Inc. That it is not a Land Survey Plat or an Improvement Survey Plat and that it is not to be relied upon for establishment of fences, buildings, or other future improvement lines.

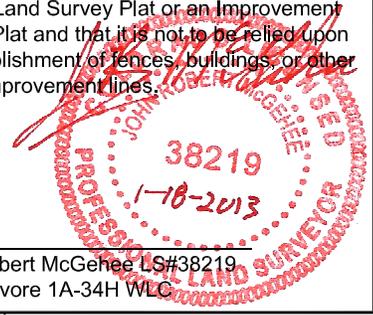

John Robert McGehee LS#38219
Well: Devore 1A-34H WLC

- Notes:
- 1) Bearings and distances based on NAD 83 Colorado North State Plane Coordinates using RTK GPS observations taken 1/16/13 by operator John Rice.
 - 2) Conversion factor to ground (1.0002753984).
 - 3) Elevations based on NAVD 88 GPS heights and Geoid 2003 corrections.
 - 4) See Location Drawing for visible improvements within 400 of pad site.
 - 5) The surface use is a uncultivated field.

NOTICE: According to Colorado law you MUST commence any legal action based upon any defect in this W.L.C. within three years after you first discover such defect. In no event may any action based upon any defect in this W.L.C. be commenced more than ten years from this said date of the certification shown hereon.