


Well FILE 4-2-17
Operator EnCana Oil & Gas (USA) Inc.
Location NWNE Section 17-T2N-R68W
County WELD
State Colorado
Field Wattenberg
Footages 1050' FNL & 1728' FEL

Spud Date: 03-28-2012

Log Tops

Sussex	4162'
Niobrara	7234'
Codell	7512'
J Sand	7944'

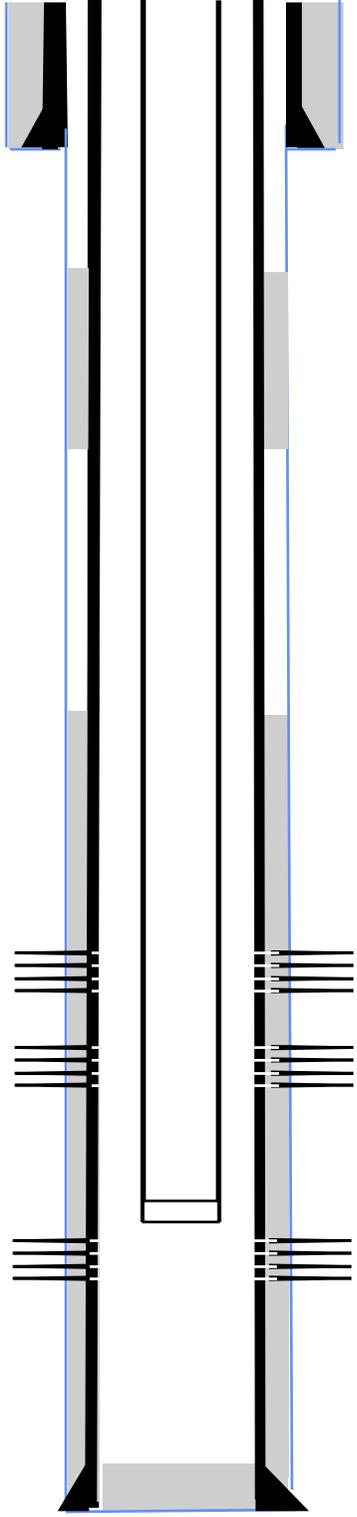

Surface Casing and Cement

8 5/8", landed @ 1008', cemented with 400 sxs

Main Hole

7-7/8" to TD

Production Casing and Cement

4-1/2", landed @ 8105', cemented with 650 sxs

CBP

Set @ 7250'. 10-03-12
 Drilled out on 10-04-12

Perf'd the Niobrara 7296-7308' @ f4 spf
 Frac'd the Niobrara 7296-7308', (48 holes), w/ 97,860 gals 18 # Vistar Hybrid cross linked gel containing 253,360 # 30/50 sand. 09-22-12

CFP

Set @ 7350'. 09-21-12
 Drilled out on 10-04-12

Perf'd the Codell from 7514'-7528' @ 3 spf
 Frac'd the Codell 7514'-7528' (42 holes) w/ 88,116 gal 22# Vistar Hybrid cross linked gel containing 250,560 # 30/50 sand. 09-21-12

CFP

Set @ 7580'. 09-21-12
 Drilled out on 10-04-12

Perf'd the J Sand from 7959'-7982' @ 2 spf
 Frac'd the J-Sand 7959'-7982', (46 holes)w/ 62,370 gal 18 # Vistar Hybrid cross linked gel containing 250,380 # 20/40 Sand. 09-20-12

Production Tubing

2-3/8" tubing, set @ 7939'

8120' — Driller's TD