

65-4

Cause No. 65

Order No. _____



FIELD Atwood-East

Location T 6+7 N. R 52+53 W.

Mer. _____ County Logan

R 53 W


R 52 W

T
7
N.

T
7
N

T
6
N.

T
6
N

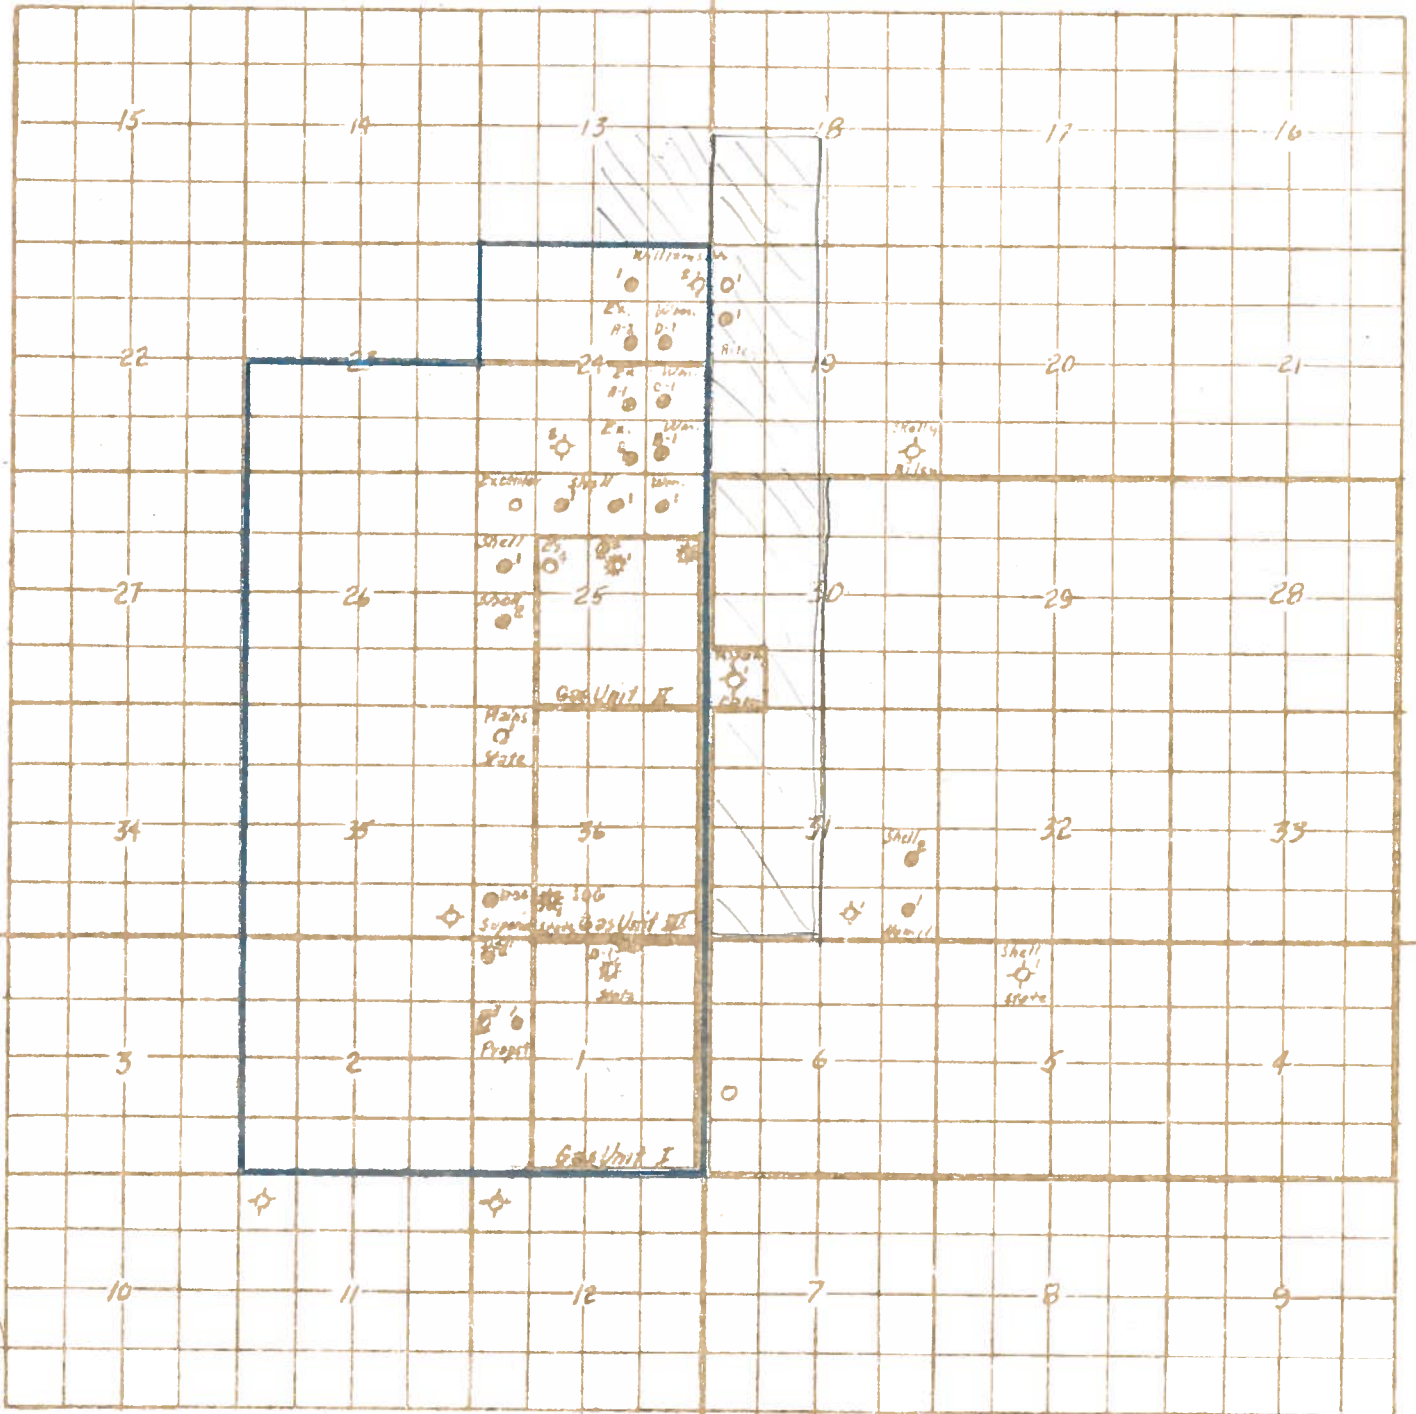

— Atwood-East

— Dune Ridge

Pure telegram dtd Sept 16, 1957 George Selinger

Dune Ridge exclude SW/4 Sec 30

W/2 Sec 31 T 7 N R 52 W

Atwood East include SW/4 Sec 18

W/2 Sec 30 T 7 N R 52 W

Continue limitation

Continuation of flow W/2 Sec 31