WPX ENERGY ROCKY MOUNTAIN, LLC
Diamond Elk, LLC PA 344-2
Parachute
SHL 2266' FSL 654' FWL (NW/4 SW/4) BHL 648' FSL 436' FEL (SE/4 SE/4 Sec. 2 T7S-R95W)
Section 1T7S-R95W 6th PM
Garfield County Colorado

Formation Tops
(Measured Depths)

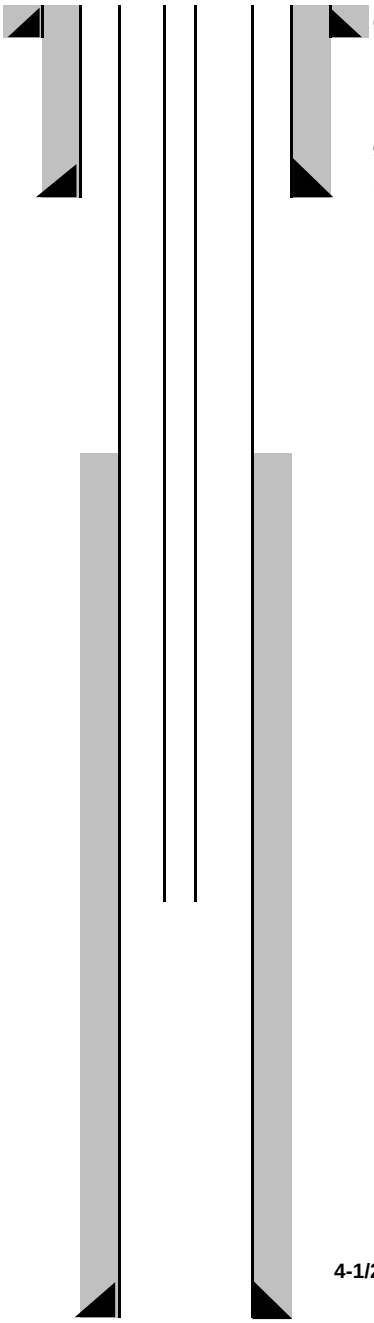

Conductor 26" Hole 18" casing/liner 60' W/44 Sks cmt

Cmt @ Surface - (Cmt circ to surf during cmt job)

9-5/8" 32.3 ppf Csg. Set @1517'
In 13-1/2" Hole W/360 Sks. Cmt

Top Of Cement @ 5240' CBL

6317-6415' Mesaverde
6466-6648' Mesaverde
6695-6917' Mesaverde
7033-7195' Mesaverde
7294-7544' Cameo
7729-7896' Cameo
7922-8077' Cameo

"G" Sand @ 2537'

Mesaverde @ 4812'

Cameo @ 7237'

Rollins @ 8176'

Tubing String: 2-3/8" Set @7918'

PBTD @ 7917'
TMD @ 8331'
TVD @ 7821'

4-1/2", 11.6 ppf. Csg. Set @8318' W/1210Sks Cmt