


KERR-MCGEE ROCKY MOUNTAIN CORP
RADEMACHER THEO J UT #1
SW NE 30 3N 67W 1,650' FNL 1,650' FEL
WELD,COLORADO
04/01/2013

AREA: S2 ROUTE: S24 Spud: 07/31/1973 WINS No.: 74661 AFE/WO#: 2079189 API#: 0512307768

GL: 4862 KB: 4872 MTD: 7740 TVD: 7740 LOG MD: 7732 PBMD: 7703 PBTVD: 7703

Directions: HWY 66 & WCR 13, E 1/2, S 1/4, E 1/4 INTO

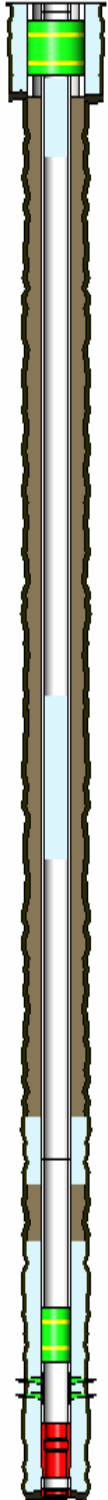

<u>HOLE SECTIONS</u>		<u>Size</u>	<u>Top</u>	<u>Btm</u>	<u>TD Date</u>			
SURFACE		12.25	10	233	07/31/1973			
PRODUCTION		7.88	233	7740	08/07/1973			
<u>TUBULARS</u>	<u>Tool Type</u>	<u>Joints</u>	<u>Size</u>	<u>Weight</u>	<u>Grade</u>	<u>Thread</u>	<u>Top D</u>	<u>Bottom D</u>
SURFACE CASING								
	Casing	5	8.63	23	G	8RD	10	231
PRODUCTION CASING								
	Casing	2	4.50	11.60	K-55	STC	10	45
	Casing	206	4.50	10.50	K-55	STC	45	6656
	Casing	32	4.50	11.60	K-55	STC	6656	7706
	Casing Float Collar	1	4.50				7706	7708
	Casing	1	4.50	11.60	K-55	STC	7708	7739
	Casing Guide Shoe	1	4.50				7739	7740
BRIDGE PLUG								
	Cast Iron Bridge Plu	1	4.50				7550	7552
BRIDGE PLUG								
	Cast Iron Bridge Plu	1	8.83				100	103
<u>CEMENT JOBS</u>	<u>Stage</u>	<u>Sacks</u>	<u>Cement Jobs</u>			<u>Top D</u>	<u>Btm D</u>	<u>cbl</u>
SURFACE CASING								
	STAGE 1	225		G		10	231	No
PRODUCTION CASING								
	STAGE 1	200		50/50 POZMIX		7150	7740	No
PRODUCTION CASING								
	SQUEEZE JOB	250	LEAD	NEAT		6400	6800	No
PRODUCTION CASING								
	ABANDONMENT PLUC	930	LEAD	NEAT		3850	4840	No
PRODUCTION CASING								
	ABANDONMENT PLUC	250	LEAD	TYPE 3		180	590	No
PRODUCTION CASING								
	ABANDONMENT PLUC	25	LEAD	TYPE 3		125	225	No
<u>PERFORATIONS</u>								
<u>Formation</u>	<u>Zone</u>	<u>Top</u>	<u>Btm</u>	<u>Date</u>	<u>Reason</u>	<u>Comments</u>		
		6210	6211	02/16/2013	CEMENT SQUEEZE			
J SAND		7609	7636	10/03/1973	PRODUCTION			

Comments: