

Current Wellbore Schematic


EnCana Oil & Gas (USA) Inc.



WELL : Davis 2A-9H – Plugged and Abandoned
LOCATION : Lat: 40.154440 Long: -104.789830
COUNTY : WELD STATE: CO
FIELD : Wattenburg - NIOBRARA
ELEVATION : 4882' (GL) 4895' (KB) Δ 13'

SPUD DATE: 4/18/2012
ABANDON DATE: 4/19/2012
API #: 05123347520000

HOLE SIZE

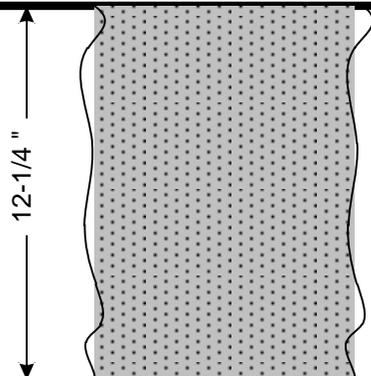

12-1/4" Hole drilled to 312'
Cement plugged entire hole and brought to surface

WELL HISTORY:

Drilling History:

While drilling surface hole, water flow returning to cellar ring with rig pumps off. Decided to abandon hole and plug with cement.

Break circulation with 10bbl water spacer. Mix and pump 215sx Swiftcem cement at 14.2ppg (yield=1.49ft³/sack) at 4bpm for 57bbl. 100lb poly flake mixed on fly. All returns through cellar. Cement brought up to 1 ft below ground level.

Filled cellar with gravel and skidded over to Davis 2H-9HX.