


Box Elder G-4 (AFTER P&A)
Revised (4/3/2013)



DESCRIPTION DEPTH WELLBORE WELL HISTORY

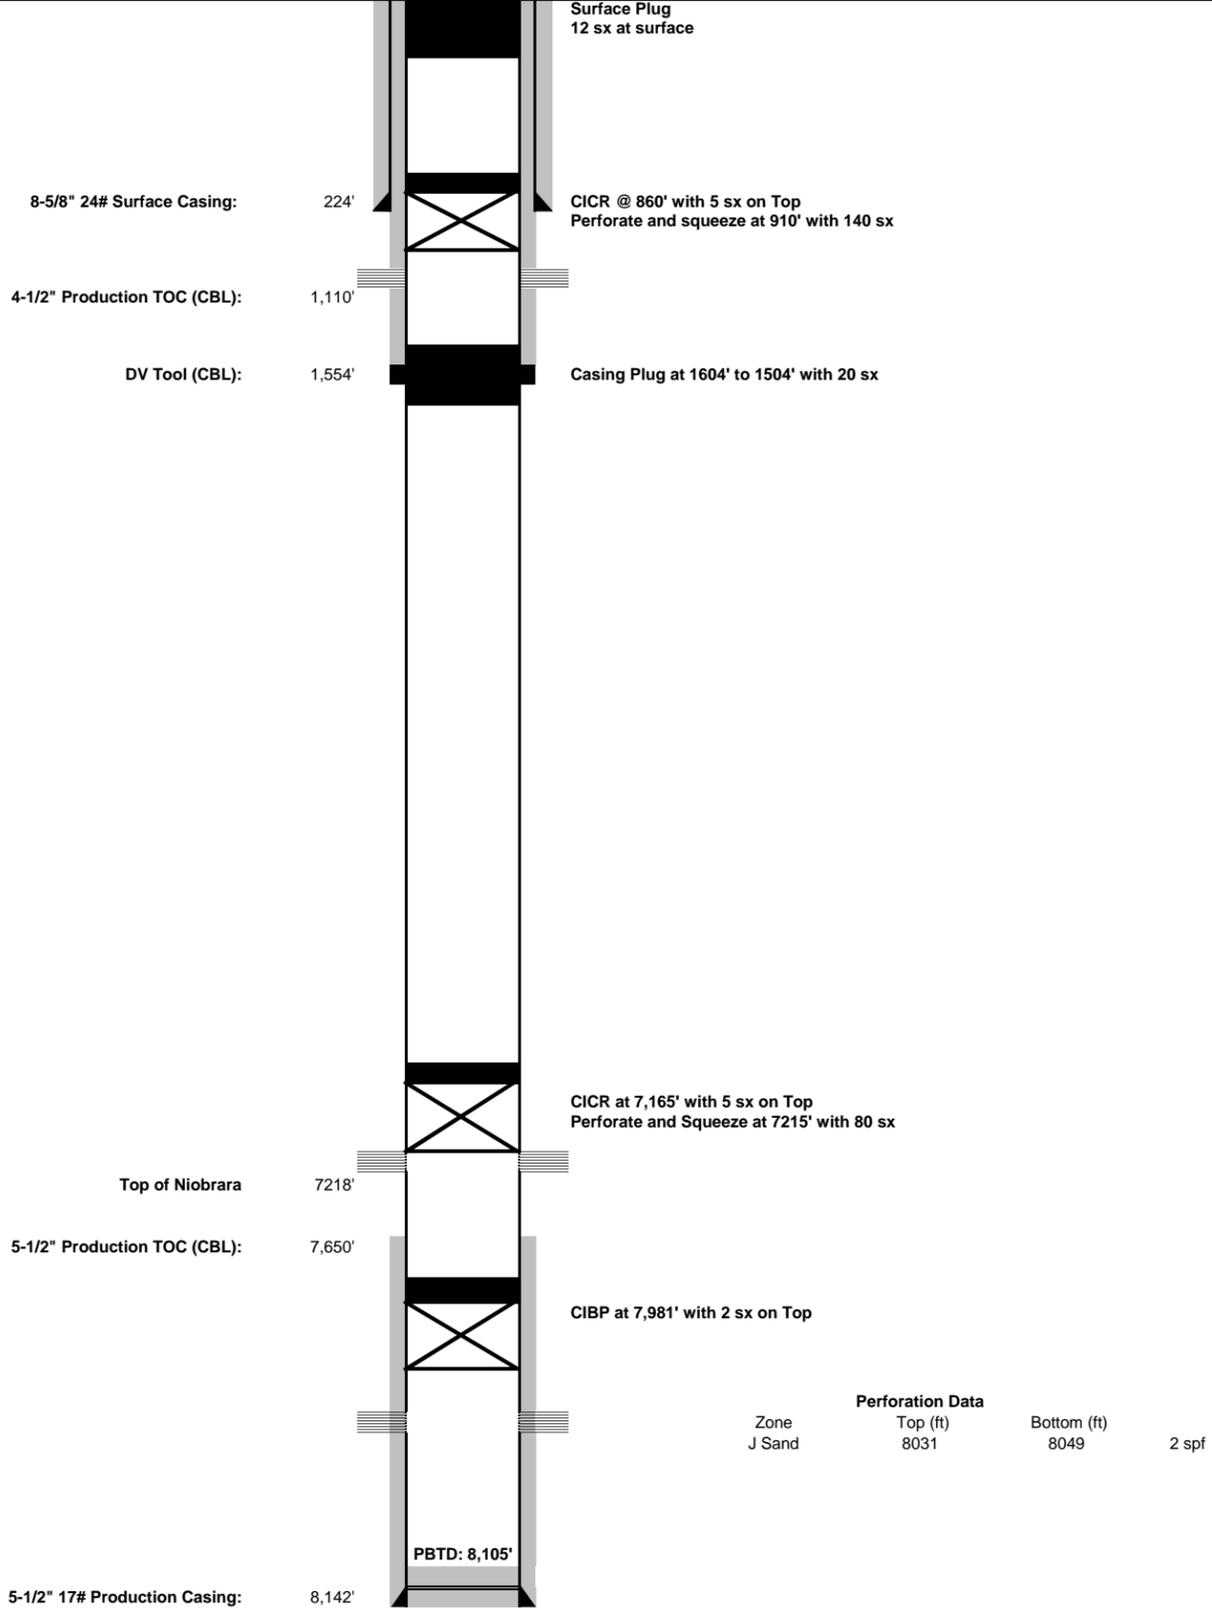

WELL: Box Elder G-4
 LOCATION: NENW SEC 24 T2S R65W
 FORMATION: J Sand
 API #: 05-001-06669
 Field: Ambush
 CLASSIFICATION:
 CURRENT STATUS: Shut In
 Spud: 5/15/1973
 TD: 5/25/1973
 1st Sales: 6/19/1973

TUBULAR DATA

Type	Size	Weight	Grade	Top	Bottom	Burst	Collapse
Surface	8 5/8"	24.0 ppf	-	0	224'		
Production	5 1/2"	17.0 ppf	-	0	8,142'		
Tubing	-	-	-	-	-		