



Physical Address: 345 Comanche St.  
Mail to: Box 384 Kiowa, CO 80117  
Ph. 303-621-8672 - Fax 303-621-2717  
www.highprairiesurvey.com

Job # 12200 Jolly Ranch 10-13

Inv # 2118


High Prairie Surveying of Kiowa, Colorado has in accordance with a request from **Night Hawk Production LLC.** has determined the location of **Jolly Ranch 10-13** to be 2475 feet FSL, and 2588 feet FEL, (90° off Section lines) of SECTION 13, Township 12s, Range 56w of the 6th Principal Meridian, Lincoln County, Colorado.

Date: Staked on 9/25/12 drawn on 9/28/12.

Re: Staked by Keith Westfall

Drawn: Drawn by Dustin Cotter

# Reference Area

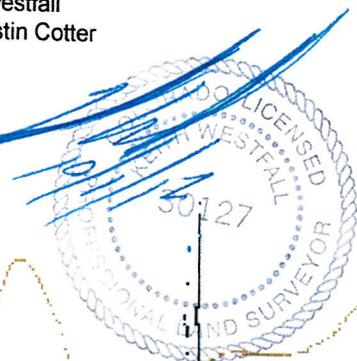

REFERENCE AREA  
LAT 39.00332 (decimal degrees)  
LONG 103.61560 (decimal degrees)

13  
Ⓜ



NIGHT HAWK PRODUCTION LLC.  
SE 1/4 SEC. 13-12-56W  
JOLLY RANCH 10-13  
LINCOLN, Co. COLORADO

GR-25

C.R. 25

13

13

N