


Lat40°, Inc. 1635 Foxtrail Drive, Suite 325 Loveland, CO 970-776-3321

PRODUCTION FACILITY ACCESS ROAD MAP

CROW CREEK STATE AC36-76HN PRODUCTION FACILITY

SECTION: 36
TOWNSHIP: 7N
RANGE: 63W

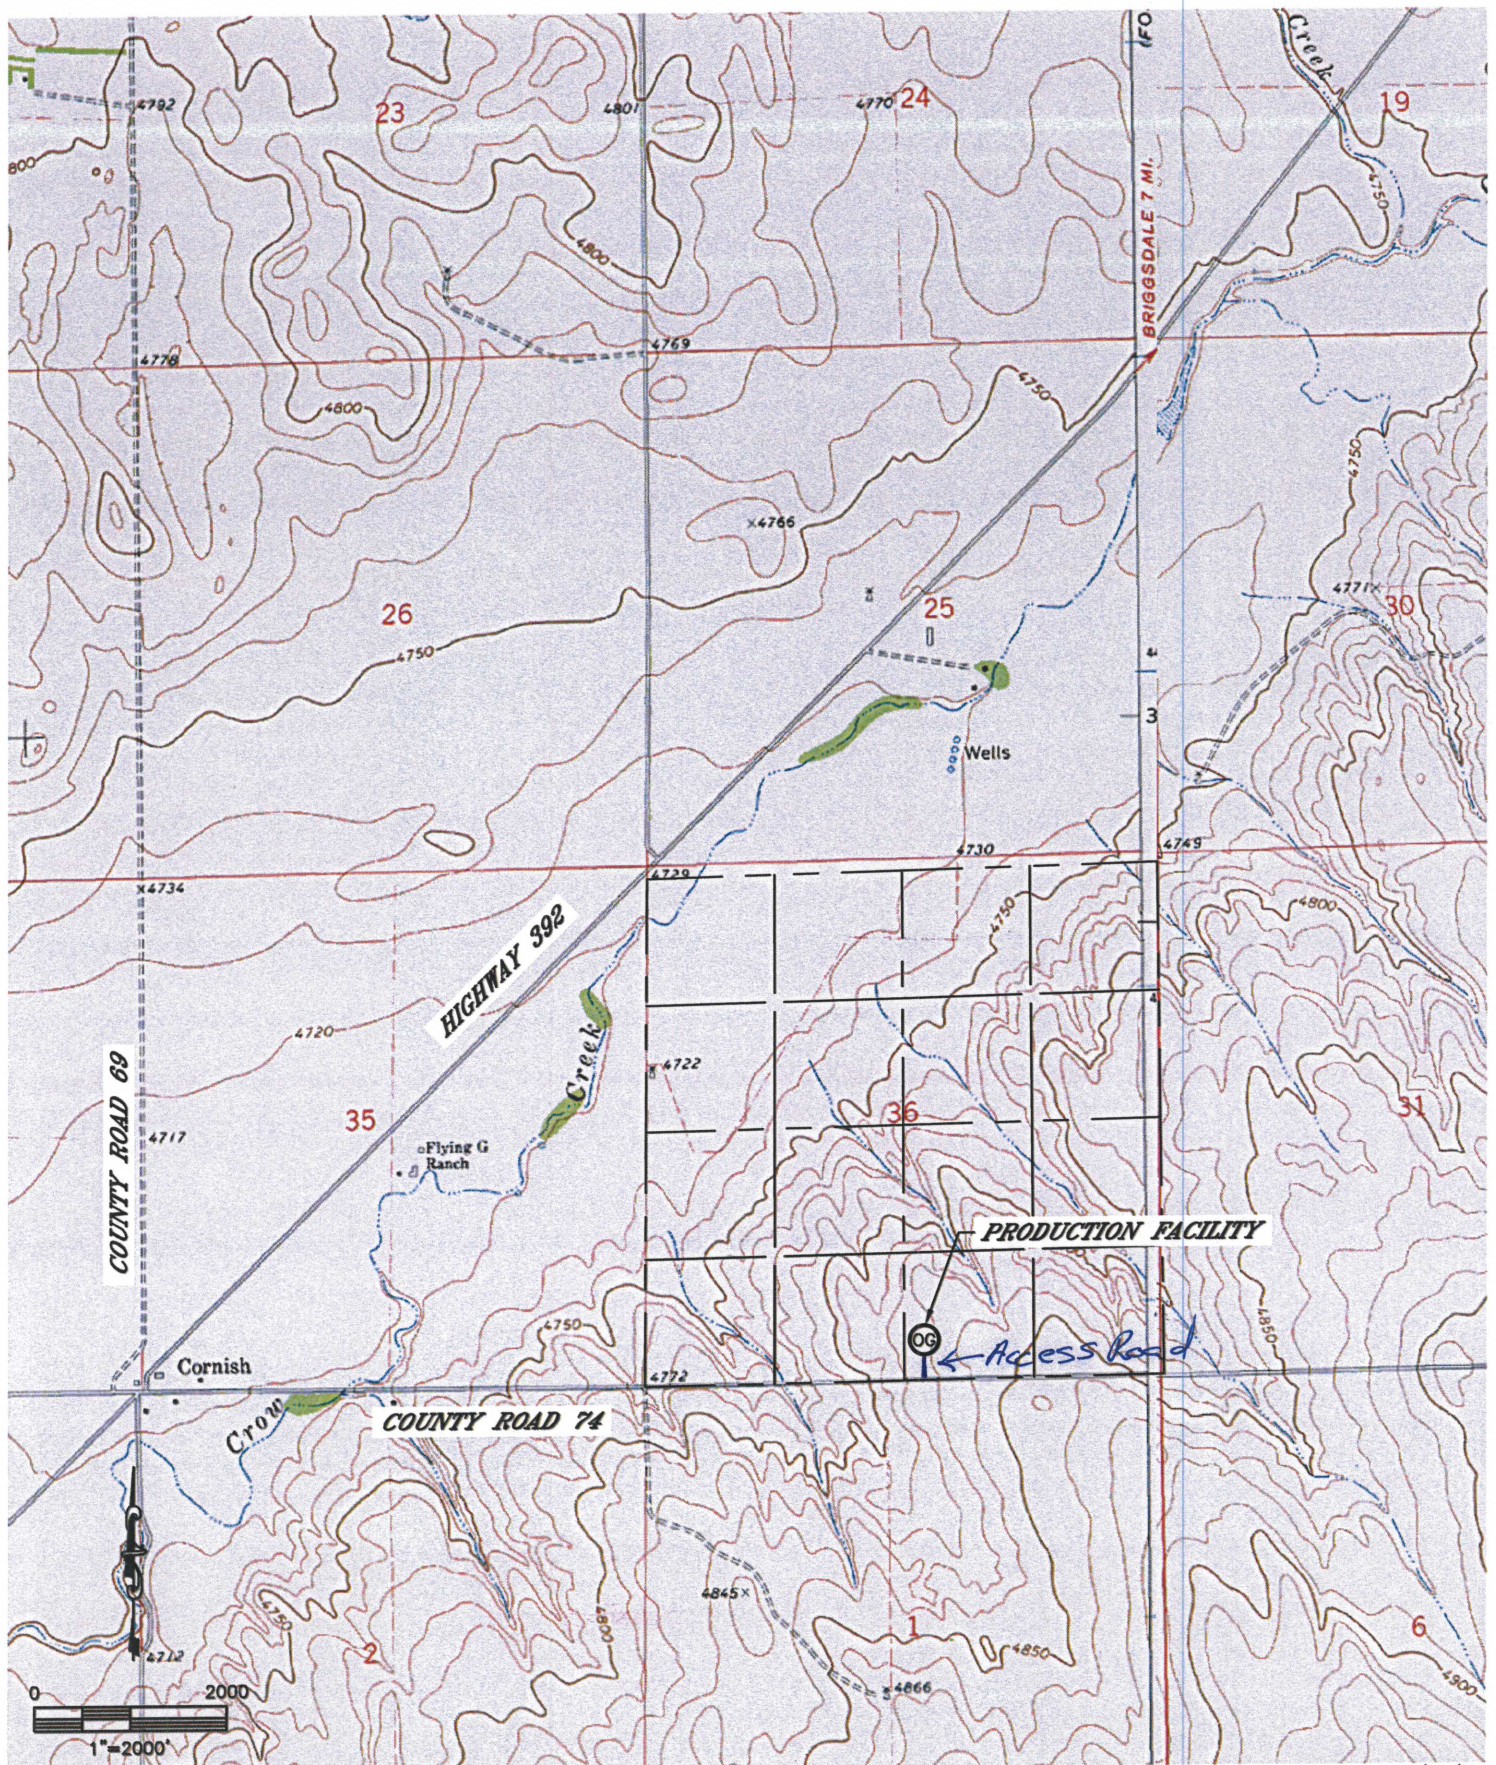

DATE: rev 11/30/12
PROJECT#: 2012141