

1625 Broadway  
Suite 2000  
Denver, CO 80202  
  
Tel: 303.228.4000  
Fax: 303.228.4280  
www.nobleenergyinc.com



April 5, 2013

Colorado Oil and Gas Conservation Commission  
The Chancery Building  
1120 Lincoln Street, Suite 801  
Denver, CO 80203  
Attn: Mr. Matt Lepore, Director

RE: Wolfpack B02-62-1HN  
Niobrara New Drill  
Township 5 North, Range 64 West, 6th P.M.  
Section 2: NW/4SW/4: 1395' FSL & 169' FWL (Surface Location)  
Section 2: SW/4SW/4: 330' FSL & 725' FWL (Beginning of Lateral)  
Section 2: SE/4SE/4: 330' FSL & 660' FEL (Bottom Hole Location)  
Weld County, Colorado

Dear Director:

Noble Energy, Inc. ("NEI") is planning to drill the captioned boundary well in accordance with the provisions of COGCC Rule 318A.e.

NEI's proposed wellbore spacing unit consists of the S/2S/2 Sec 2, N/2N/2 Sec 11, T5N, R64W, creating a 320-acre wellbore spacing unit for the Niobrara formation. NEI is the only owner within the proposed wellbore spacing unit, therefore NEI hereby attests that no notice letters are required under COGCC Rule 318A(I).e.(6).

Enclosed are copies of the following documents to assist you in your review and approval of NEI's proposed APD for the captioned well:

- Map & plat illustrating proposed wellbore spacing unit.

Thank you for your attention to the enclosed. NEI respectfully requests that the COGCC review the enclosed information and approve the Application for Permit to Drill the captioned well.


Sincerely,

Justin Garrett  
Regulatory Analyst II  
Noble Energy Inc.

# Wolfpack B02-62-1HN

Proposed Spacing Unit – Noble Energy, Inc

S/2S/2 Section 2 and N/2N/2 Section 11,  
Township 5 North, Range 64 West

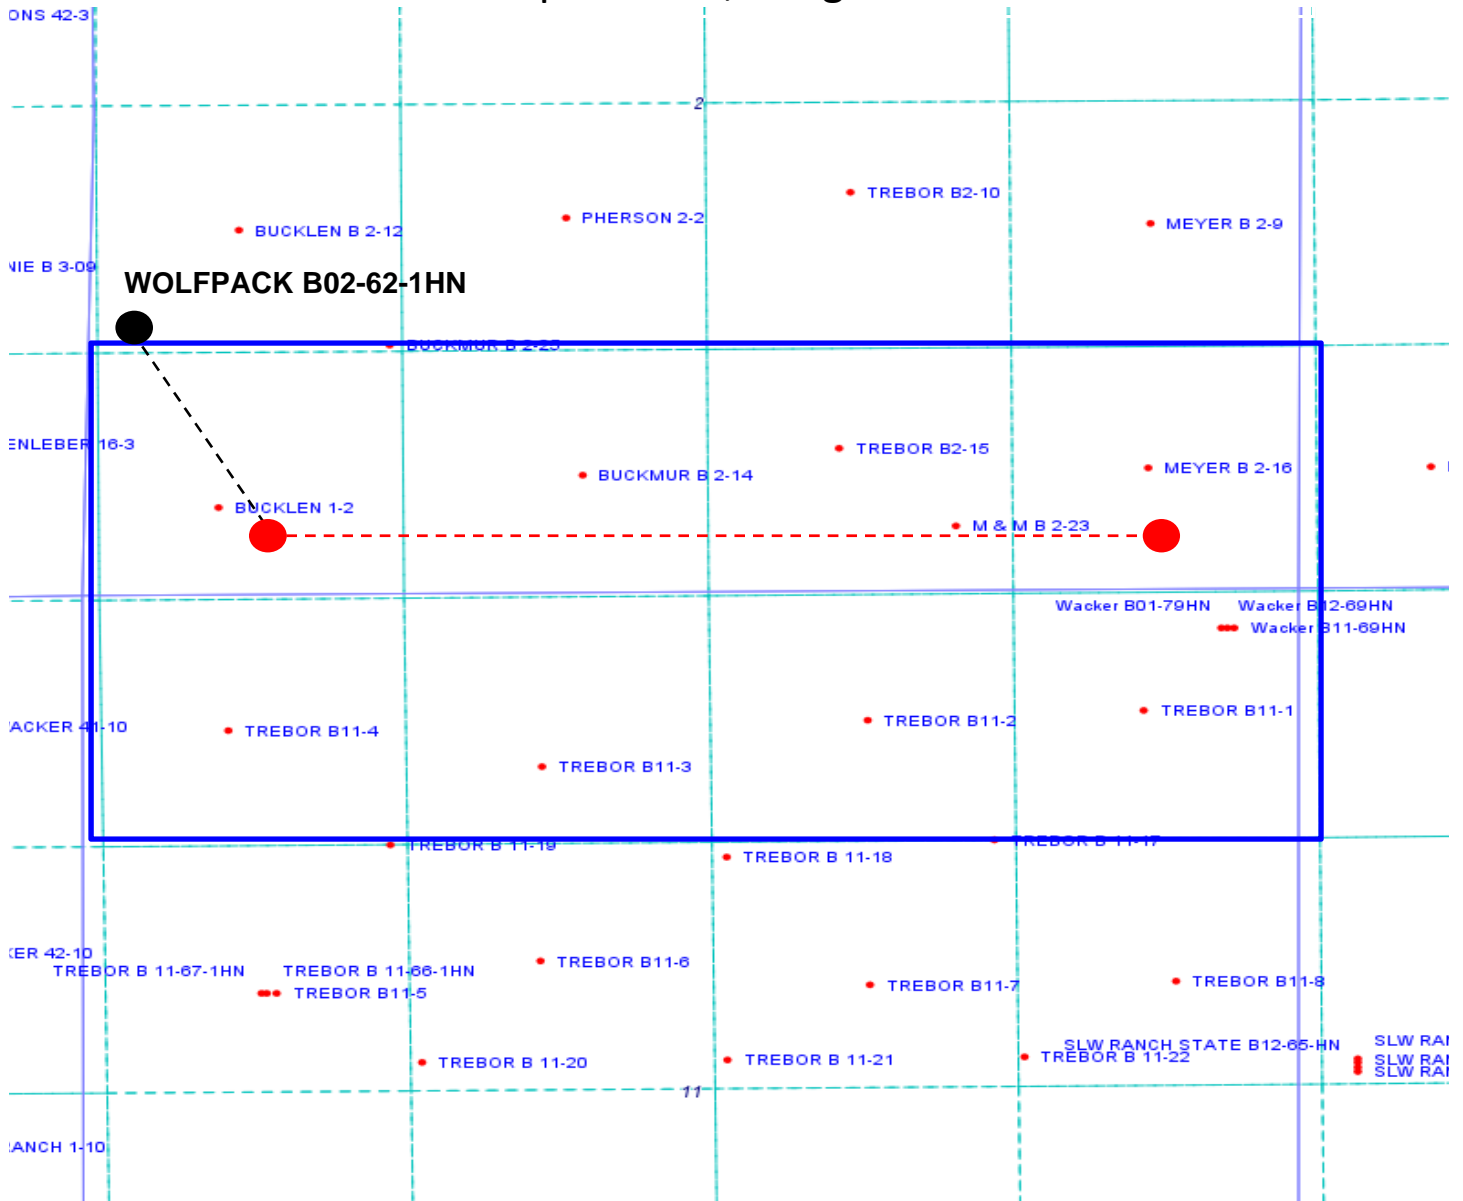

## Legend



Proposed 322.47± acre spacing unit




Bottom Hole Location

Lat40°, Inc. 1635 Foxtrail Drive, Suite 325 Loveland, CO 970-776-3321

# WELL LOCATION CERTIFICATE

THIS MAP DOES NOT REPRESENT A BOUNDARY SURVEY

SECTION: 2  
TOWNSHIP: 5N  
RANGE: 64W

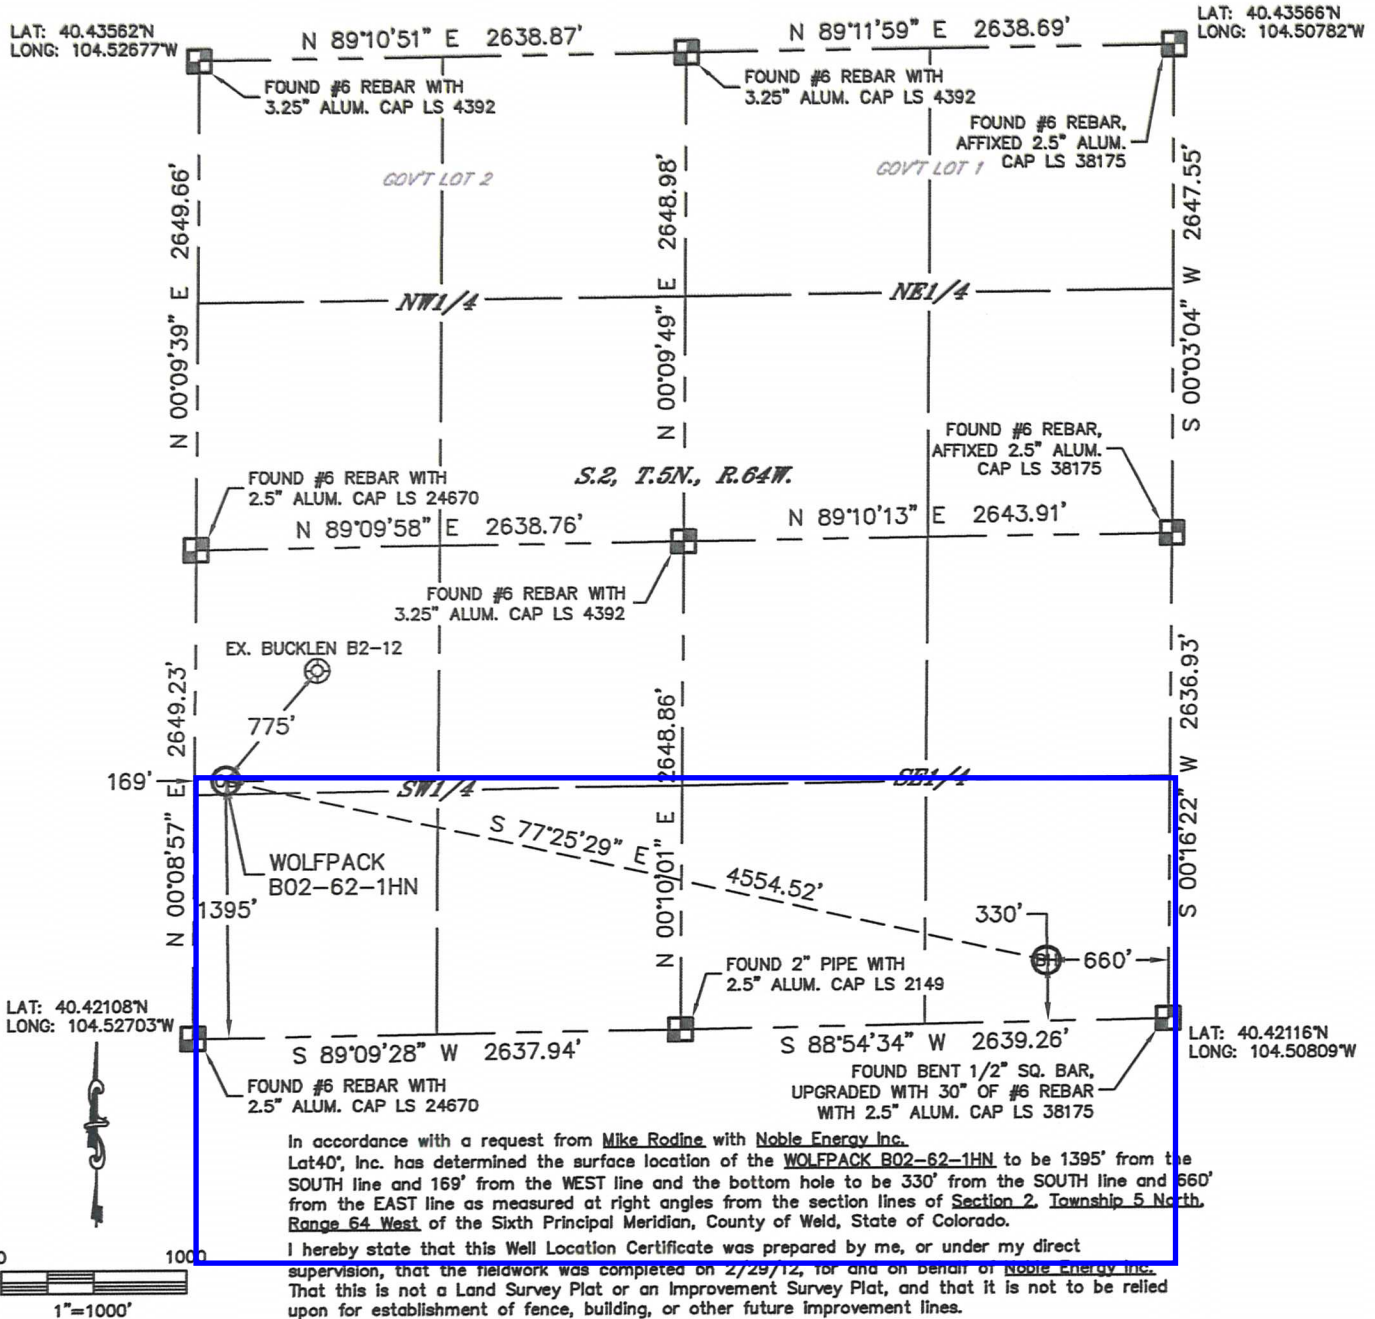

## NOTE:

- 1) Bearings shown are Grid Bearings of the Colorado State Plane Coordinate System, North Zone, North American Datum 1983/2007. The lineal dimensions as contained herein are based upon the "U.S. Survey Foot."
- 2) Ground elevations are based on an observed GPS elevation (NAVD 1988 DATUM).
- 3) NEAREST EXISTING WELL: BUCKLEN B2-12, 775'
- 4) IMPROVEMENTS: See LOCATION DRAWING for all visible improvements within 400' of disturbed area.
- 5) SURFACE USE: CROP LAND
- 6) INSTRUMENT OPERATOR: ADAM KELLEY

## SURFACE LOCATION

LAT: 40.42491°N  
LONG: 104.52638°W  
PDOP: 1.9  
ELEV: 4615'  
1/4, 1/4: NW1/4SW1/4  
NEAREST PROPERTY LINE: 169' WEST


## BOTTOM HOLE

LAT: 40.42205°N  
LONG: 104.51044°W

## LEGEND

- = ALIQUOT MONUMENT AS DESCRIBED  
○ = CALCULATED POSITION

Brian T. Brinkman—On behalf of Lat40°, Inc.  
Colorado Licensed Professional Land Surveyor No. 38175  
DATE: 3/5/2012  
PROJECT#: 2012029

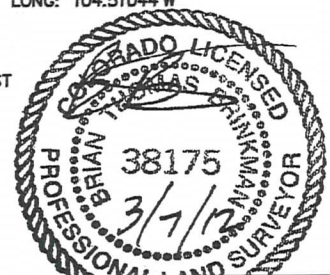

## NOTE

According to Colorado law, you must commence any legal action based upon any defect in this W.L.C. within three years after you discover such defect. In no event, may any action based upon any defect in this survey be commenced more than ten years after the date of the certificate shown hereon. (13-80-105 C.R.S.)