

KERR-MCGEE ROCKY MOUNTAIN CORP

DECHANT 16-1

SE SE 1 2N 65W 469' FSL 460' FEL

WELD,COLORADO

03/08/2013

AREA: N5

ROUTE: N52 Spud: 12/08/2005

WINS No.: 75423

AFE/WO#: 88326738

API#: 0512323346

GL: 4828

KB: 4840

MTD: 7710


TVD: 7710

LOG MD: 7682

PBMD: 7692

PBTVD: 7692

Directions: CR 22 & CR 49, N 1 5/10, W 5/10, S 2/10, E 5/10 INTO.

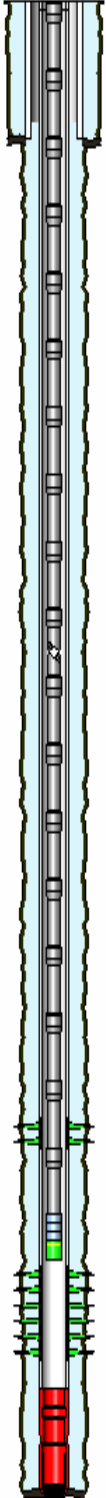

<u>HOLE SECTIONS</u>	<u>Size</u>	<u>Top</u>	<u>Btm</u>	<u>TD Date</u>
SURFACE	12.25	12	895	12/09/2005
PRODUCTION	7.88	895	7710	12/13/2005

<u>TUBULARS</u>	<u>Tool Type</u>	<u>Joints</u>	<u>Size</u>	<u>Weight</u>	<u>Grade</u>	<u>Thread</u>	<u>Top D</u>	<u>Bottom D</u>
SURFACE CASING	Casing	20	8.63	24	J-55	STC	12	883
PRODUCTION CASING	Casing	1	4.50	11.6	I-80	LTC	12	53
	Casing	183	4.50	11.6	I-80	LTC	53	7704
	Casing Float Collar	1	4.50				7704	7705
	Casing Guide Shoe	1	4.50				7705	7706
PRODUCTION TUBING	Tubing	238	2.38	4.70	J-55	External-Ups	12	7508
	Seating Nipple	1	2.38				7508	7509
	Notched Collar	1					7509	7509

<u>CEMENT JOBS</u>	<u>Stage</u>	<u>Sacks</u>	<u>Cement Jobs</u>	<u>Top D</u>	<u>Btm D</u>	<u>cbl</u>
SURFACE CASING	STAGE 1	620	NEAT	12	883	No
PRODUCTION CASING	STAGE 1 MIDDLE	150	LITE	5350	6644	Yes
	STAGE 1 TAIL	230	50/50 POZ-MIX	6644	7707	Yes
	STAGE 1 LEAD	155	LITE	3730	5350	Yes
PRODUCTION CASING	REMEDIAL CEMENT		SPACER FRESH WATER	768	3725	Yes
	REMEDIAL CEMENT		PRE FLU&SMS WATER	768	3725	Yes
	REMEDIAL CEMENT		SPACER FRESH WATER	768	3725	Yes
	REMEDIAL CEMENT		DISPLAC&FRESH WATER	768	3725	Yes
	REMEDIAL CEMENT	675	LEAD NEAT CEMENT	768	3725	Yes

<u>PERFORATIONS</u>	<u>Formation</u>	<u>Zone</u>	<u>Top</u>	<u>Btm</u>	<u>Date</u>	<u>Reason</u>	<u>Comments</u>
	CODELL		7076	7090	01/05/2006	PRODUCTION	
	J SAND		7546	7550	11/03/2006	PRODUCTION	
	J SAND		7556	7561	11/03/2006	PRODUCTION	
	J SAND		7565	7600	11/03/2006	PRODUCTION	

Comments: