


P&A Wellbore Diagram

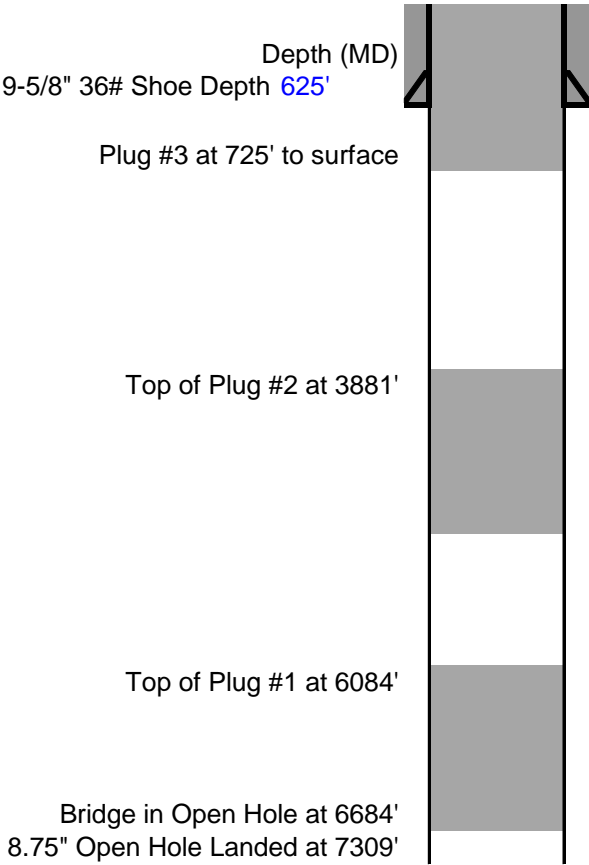

Cement Specifications and Volumes
15.8 ppg PlugCem; Class G; 1.15 cf/sk yield
Plug #1 & 2 Volume: 44.6 bbl
Plug #3 Volume: 56.18 bbl